


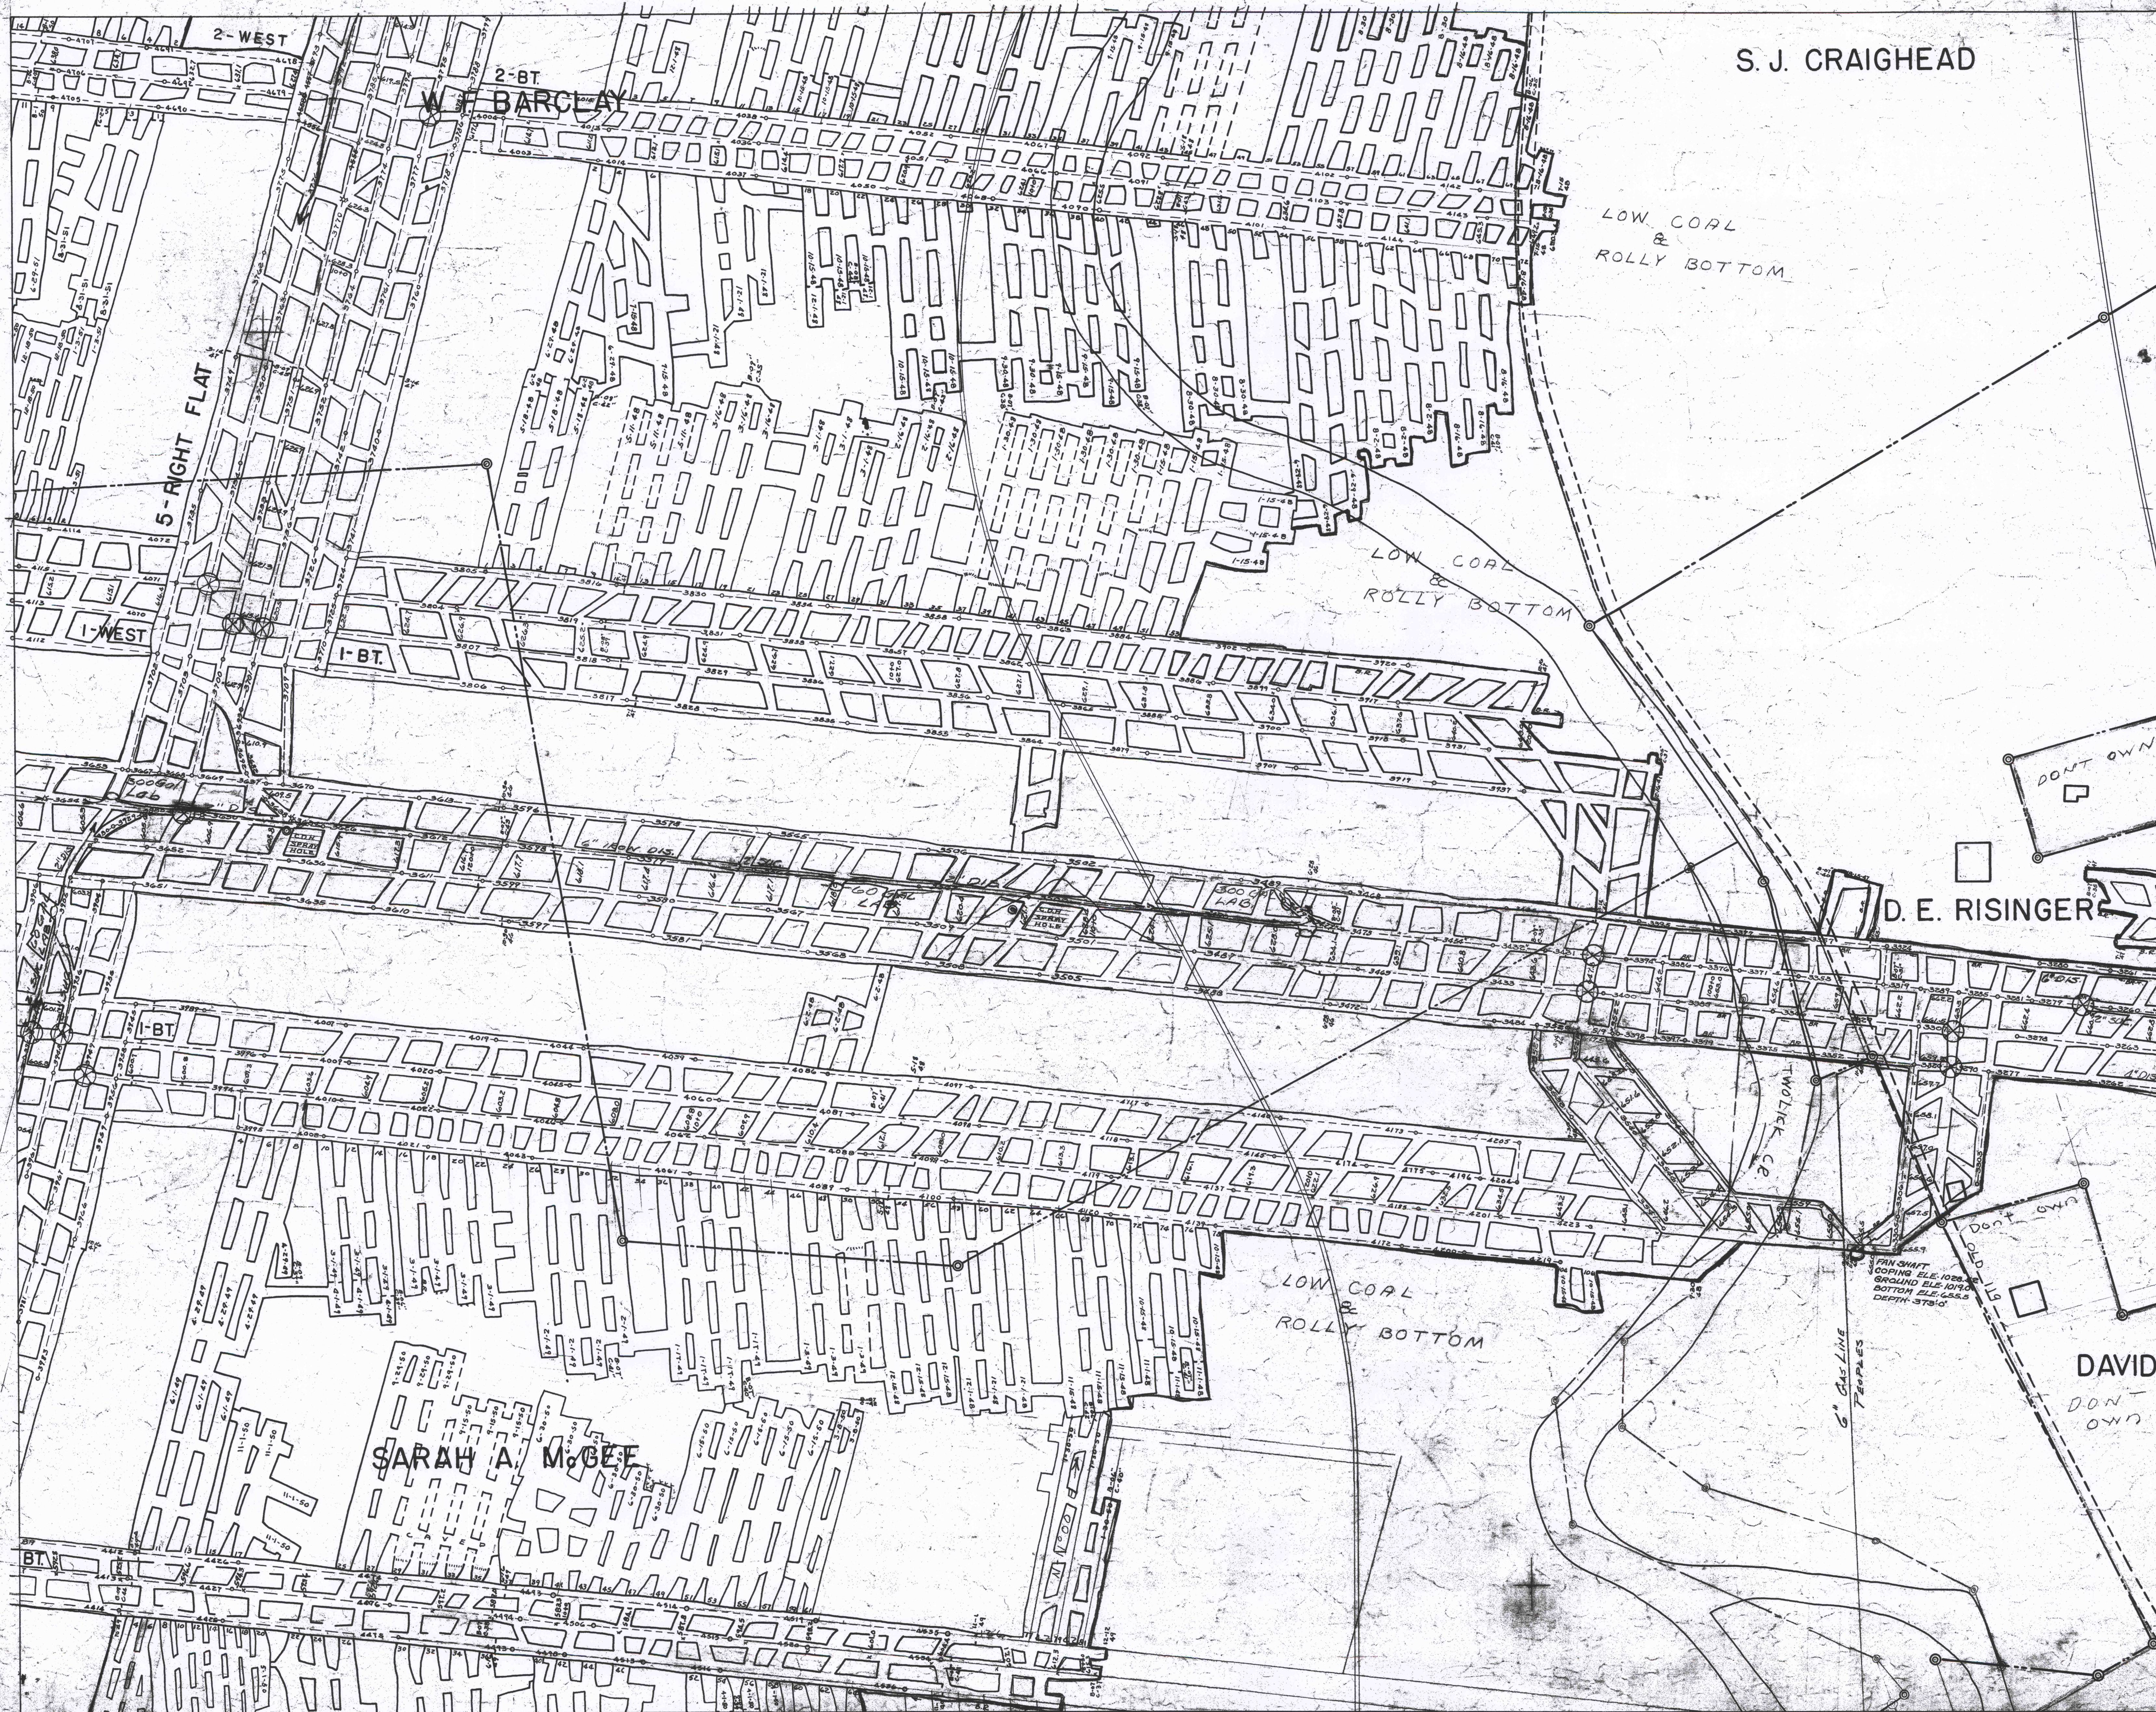

MICROFILM 02 28 A-26 29 41
'B' Seam