


12-47

DRAWER 41

WATERMAN #2

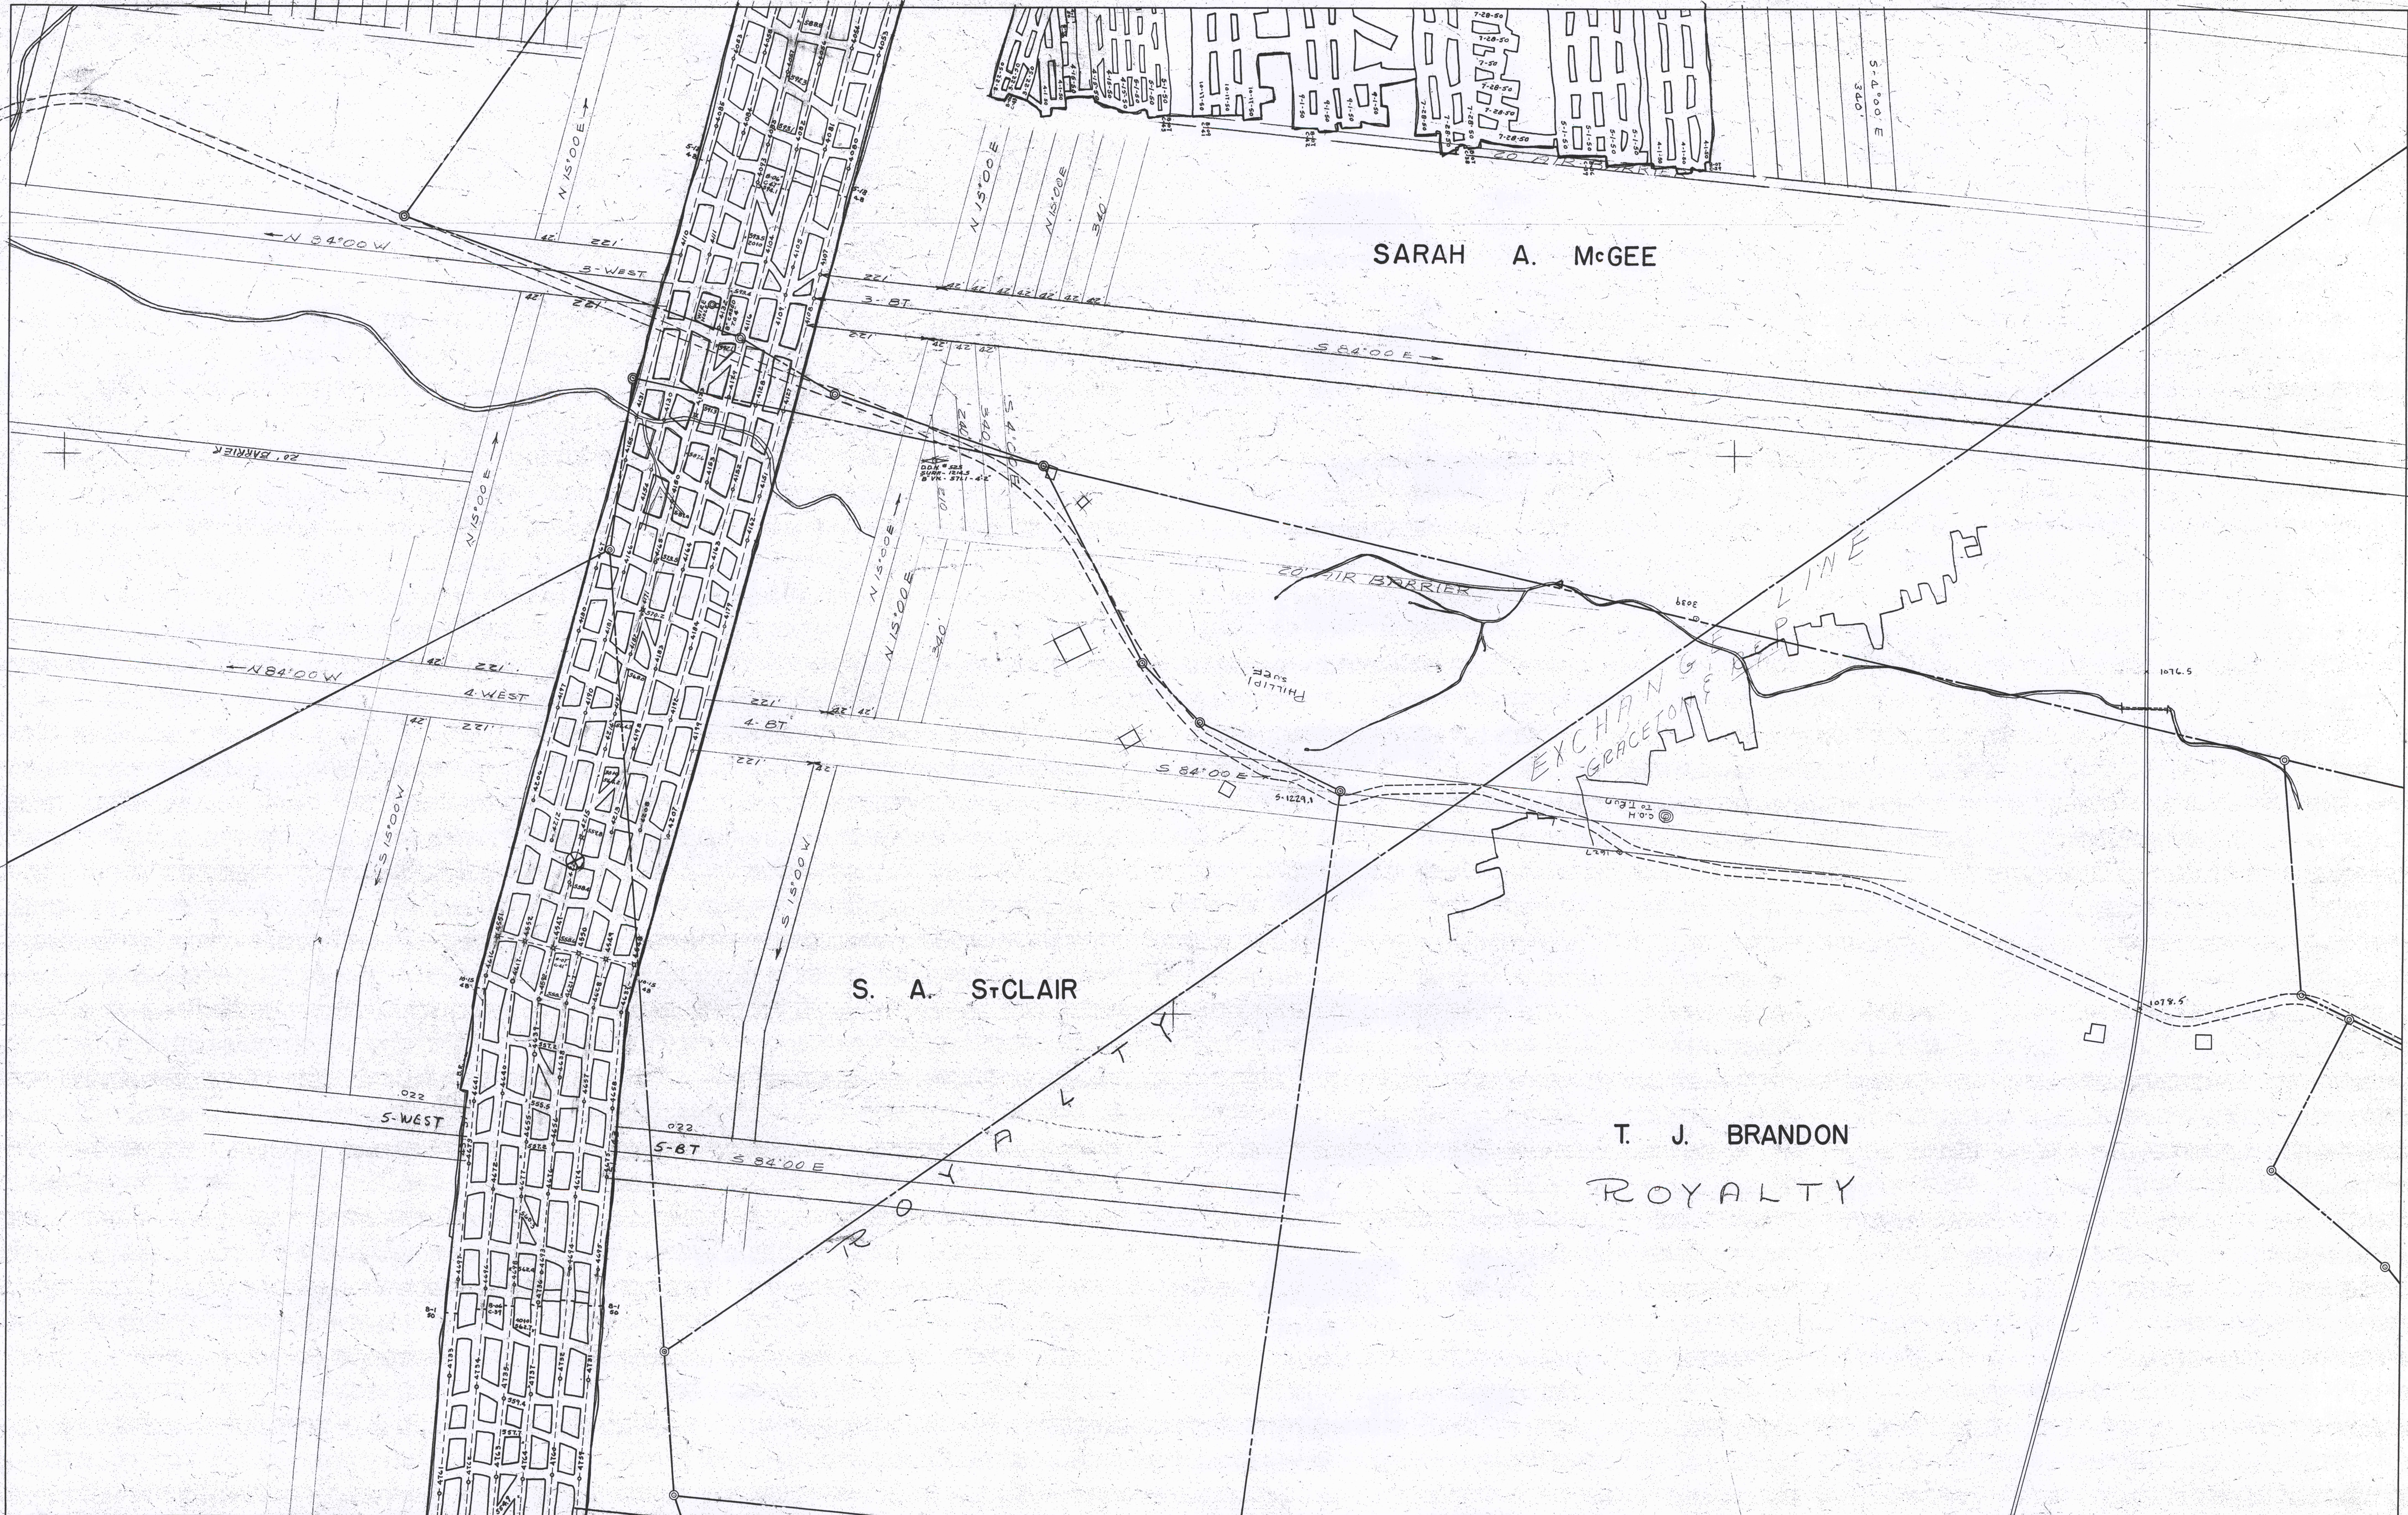

S. A. STCLAIR

SARAH A. MCGEE

T. J. BRANDON
ROYALTY


20' AIR BARRIER

WATERMAN #2

DRAWER 41

MICROFILM 02 28 A-23 39 41
"B" Seam