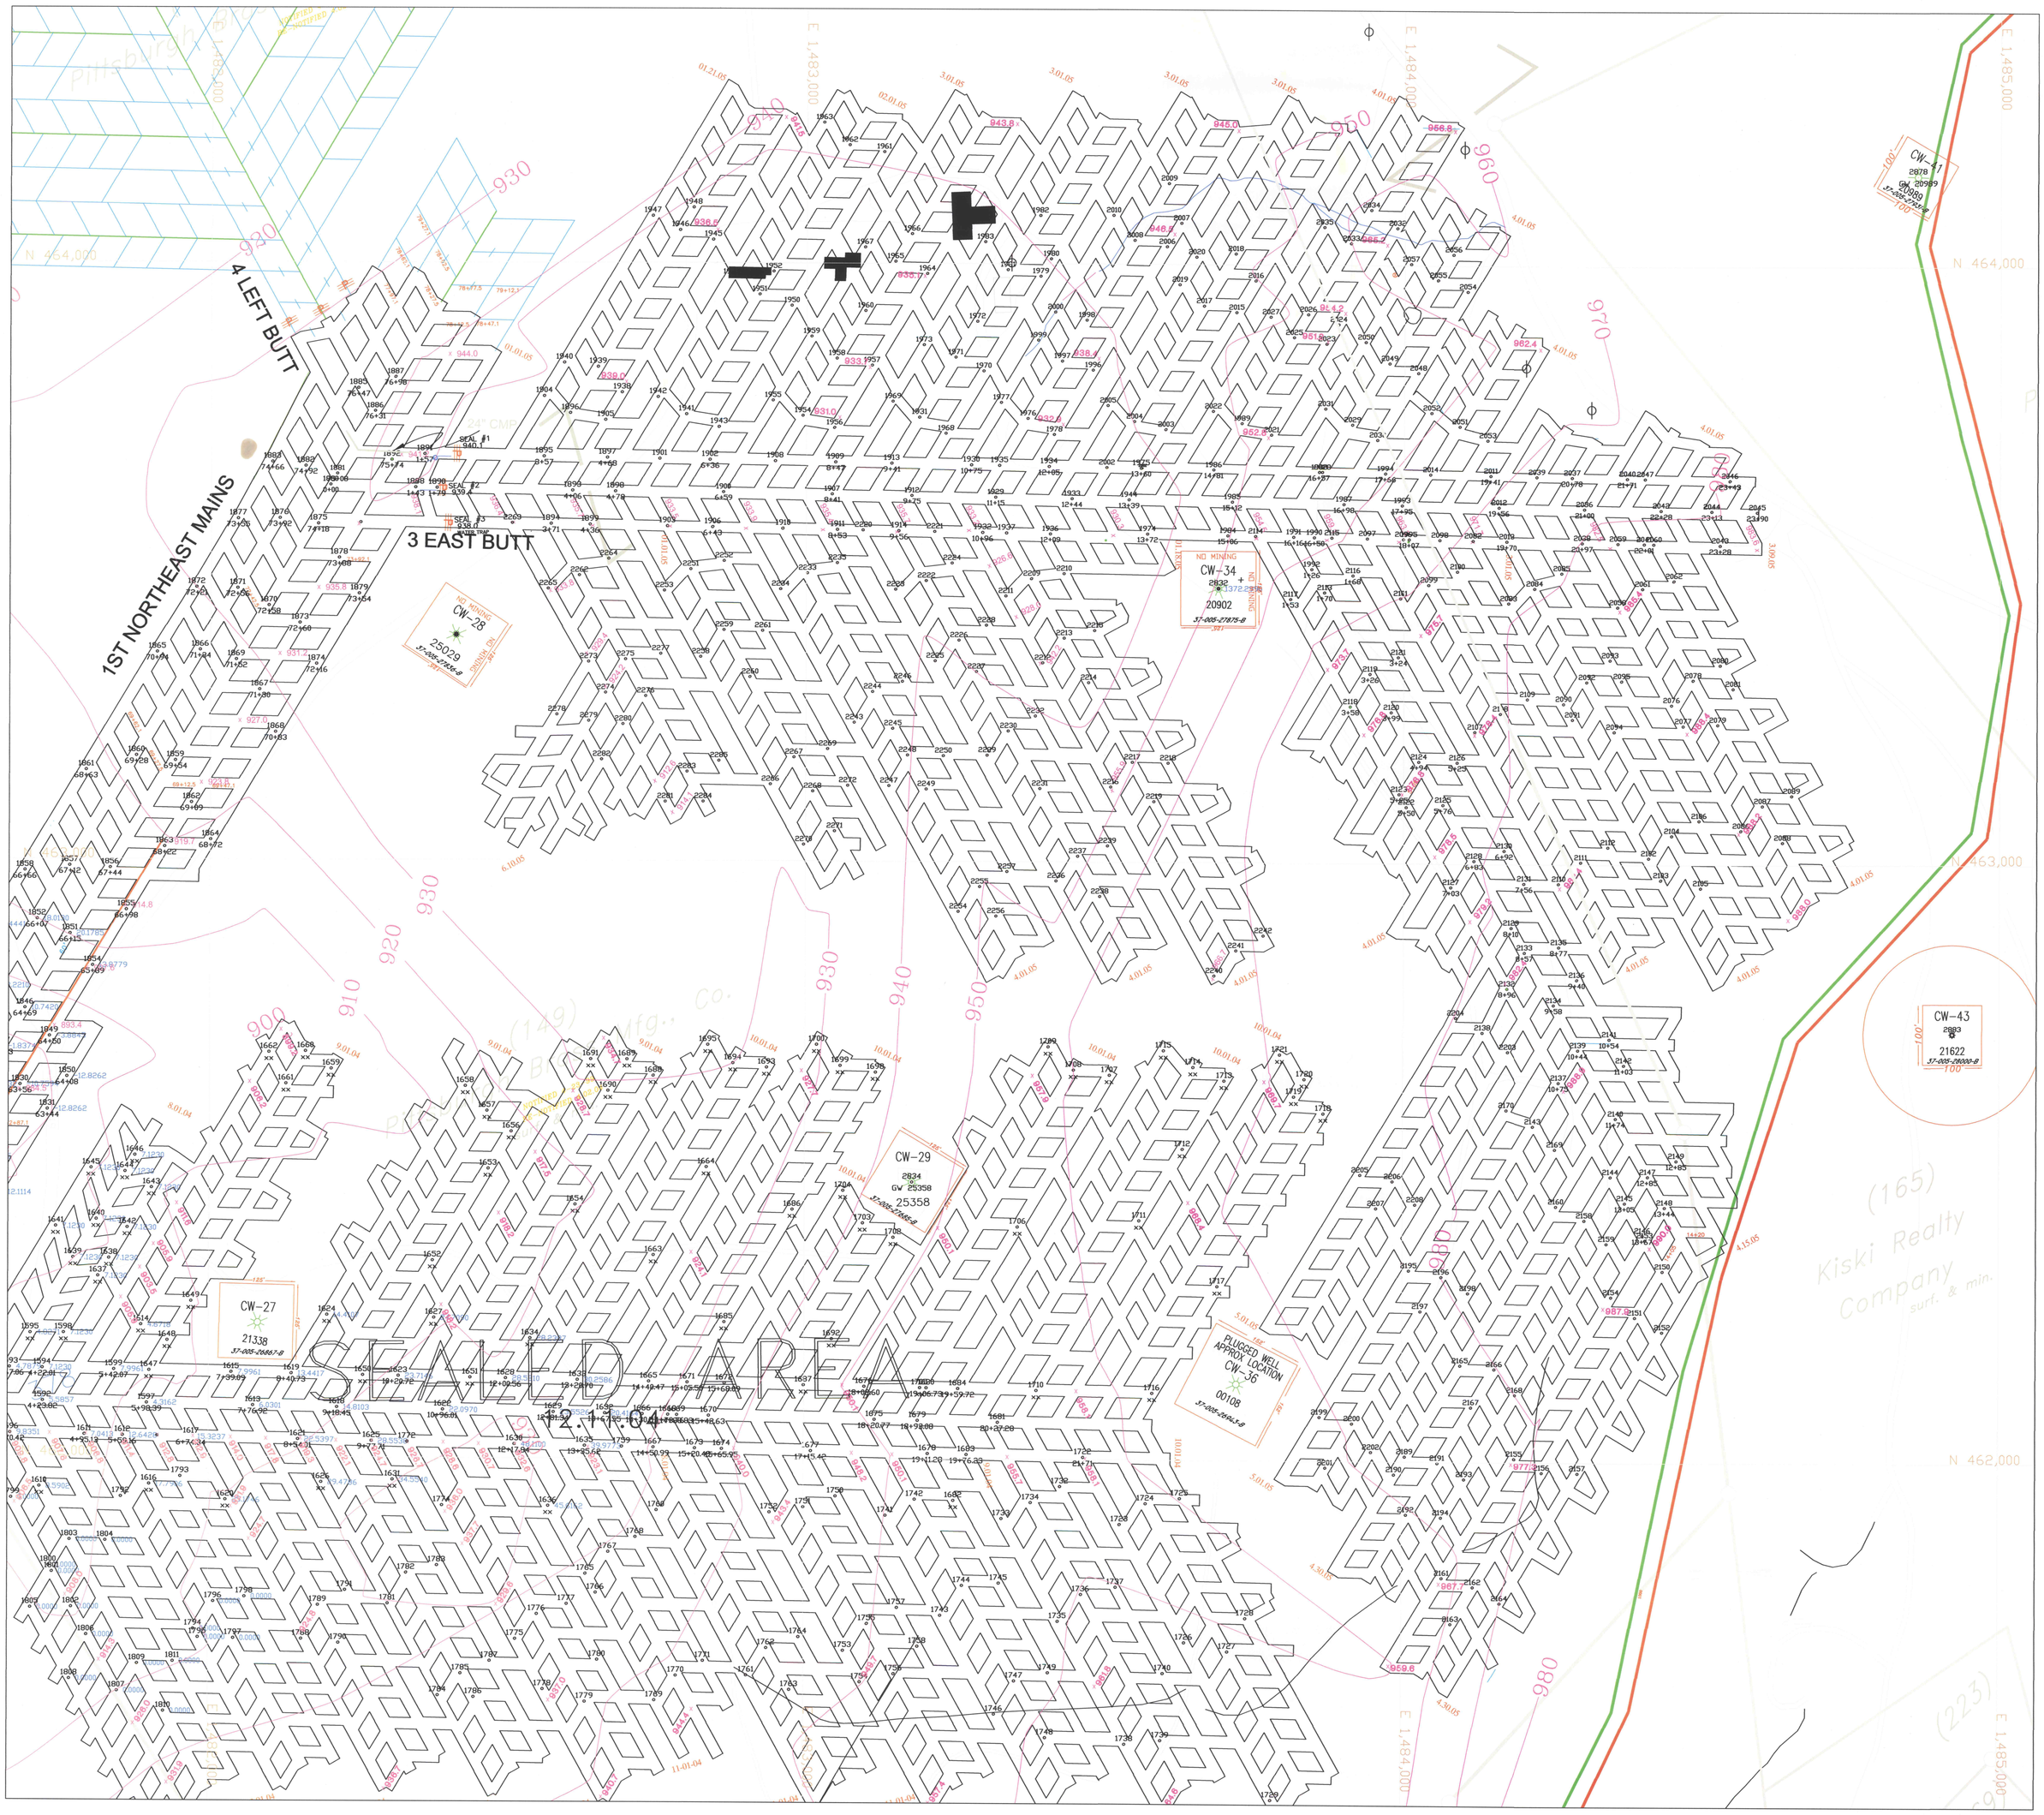

COAL CONTOUR

PERMIT BOUNDARY

SUBSIDENCE CONTROL PLAN BOUNDARY

Rosebud Mining Company

TRACY LYNNE MINE
EXTENT OF MINE WORKINGS
3 EAST BUTT OFF 1 NORTHEAST MAINS

COMMONWEALTH OF PENNSYLVANIA
REGISTERED PROFESSIONAL
DENNIS E. GRELLE
ENGINEER
NO. 27319-E

DATE: 6.13.05

Lower Kittanning Coal Seam

Kiskiminetas Township, Armstrong County, PA

1001 Brownstown Road
Apollo, PA 15613

ID No. 36 08603 CMAP No. 03961301

Scale: 1 in. = 100 ft.

N