

5


13

BIG BEND DRAWER 38

13

8

5

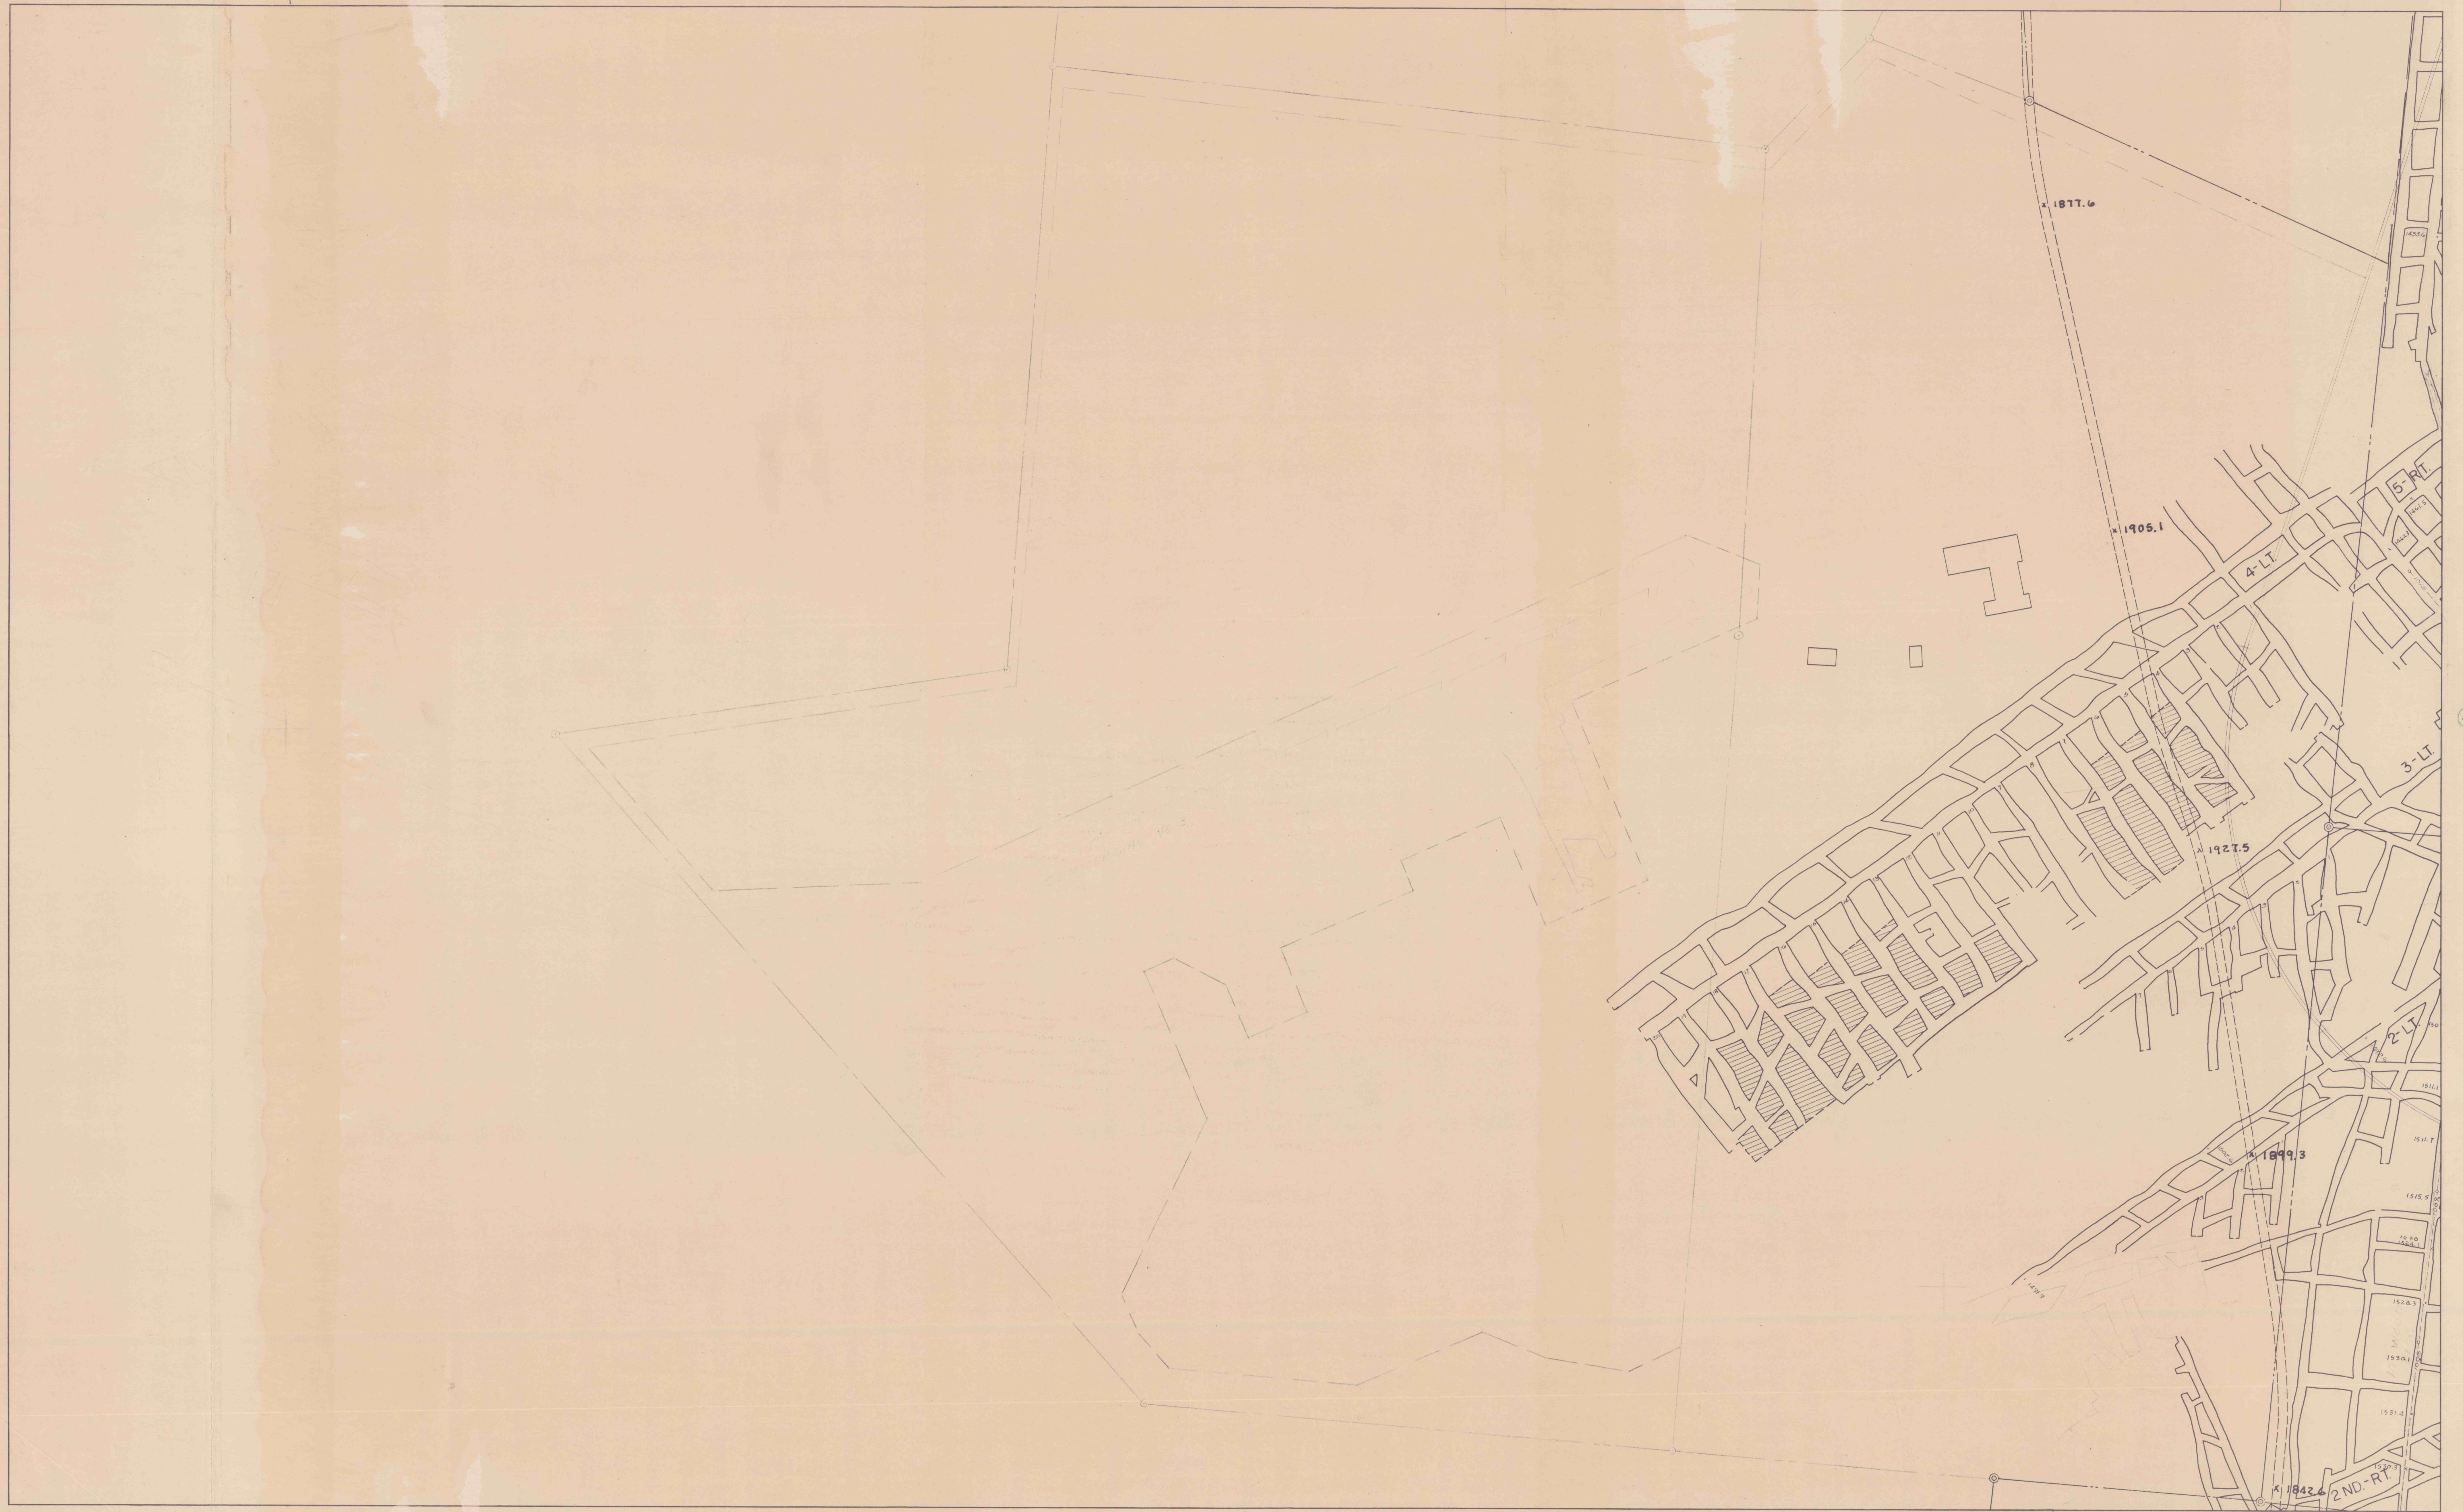

5

BIG BEND DRAWER 38

2

2

357/5

5