BIG BEND DRAWER 38
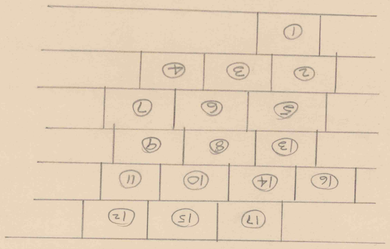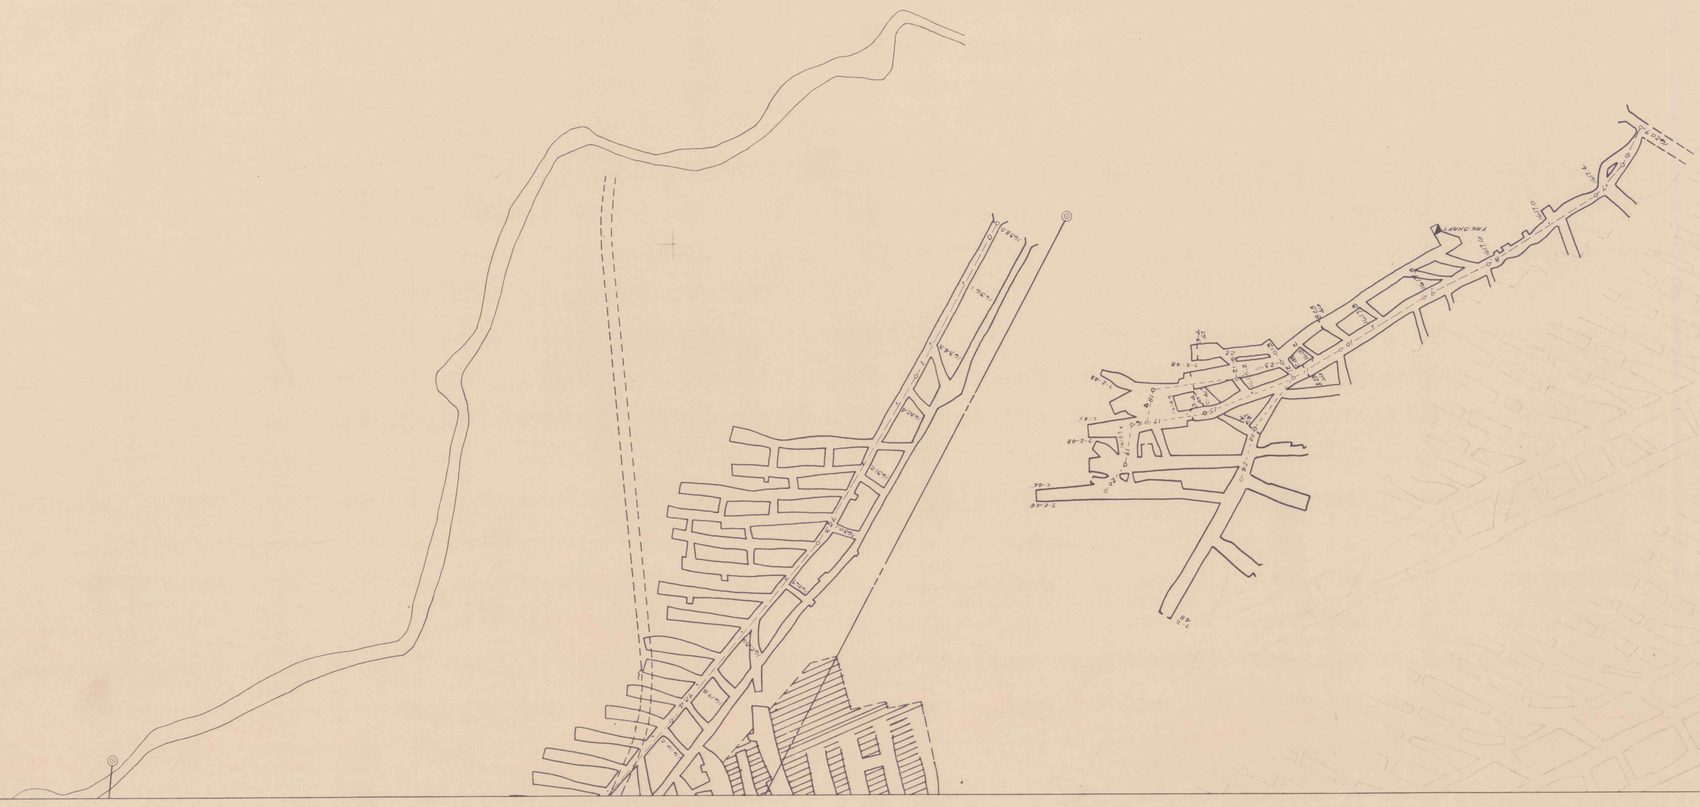
351 — (1)