

KNISELEY COAL CO.  
SCALE 1"=100'

HENRY NORTH

JOHN F. MULHOLLEN

LINE HEADING


NO. 2 MAIN

ROOMS N 1800 E  
45 CENTERS

ROOMS N 1800 E  
45 CENTERS

ROOMS N 1800 E  
45 CENTERS

ROOMS N 1800 E  
45 CENTERS

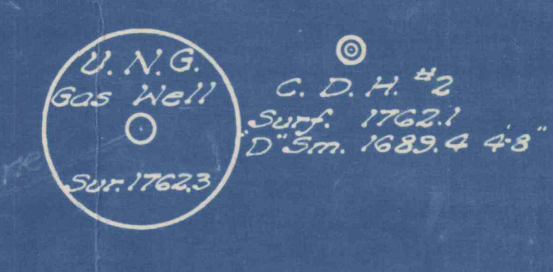



