

(Formerly) KATHERINE GARMAN
420 AC. TT.
Now T. BARNES Est.




Lease Area 18.2 ± Ac.

S. P. LANTZKY
KATHERINE GARMAN (FORMERLY)
420 AC. TT.
Now BARNES EST.

EMPIRE COAL MINING CO.

84 ± Ac. Sur.
Sold to Empire

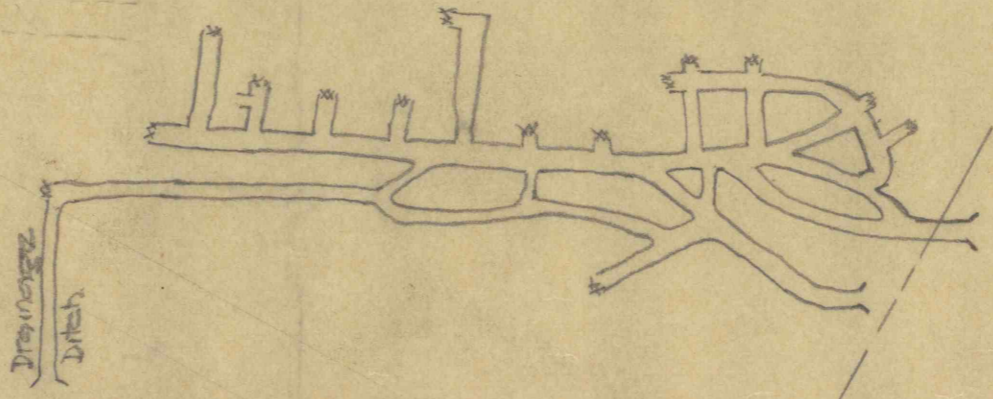

Fence Line - Barnes Estate
N 3° 20' E 300'
N 20° 00' W 196'

Right-of-way Line for Empire Branch NYC & HR R.R.
605 ft.
520 ft.
R.R.

To Barnesboro

MAP OF
"D" SEAM LEASE AREA
TO GEORGE CHUHRAN
BY BARNES & TUCKER CO
BARNESBORO, CAMBRIA CO., PA
Sc. 1" = 100 ft. Oct. '37.

C. P. Brister

DE-104

B-5424

100