


Peale, Raccock & Kerr Corp.  
 No 9, Mine, Workings under  
 Barnds Coal Co # 15 Houses  
 Taken from Blubaker Map  
 Bakerton, Cambria Co. Pa.  
 Scale 1"=100ft. Nov 28, '32.

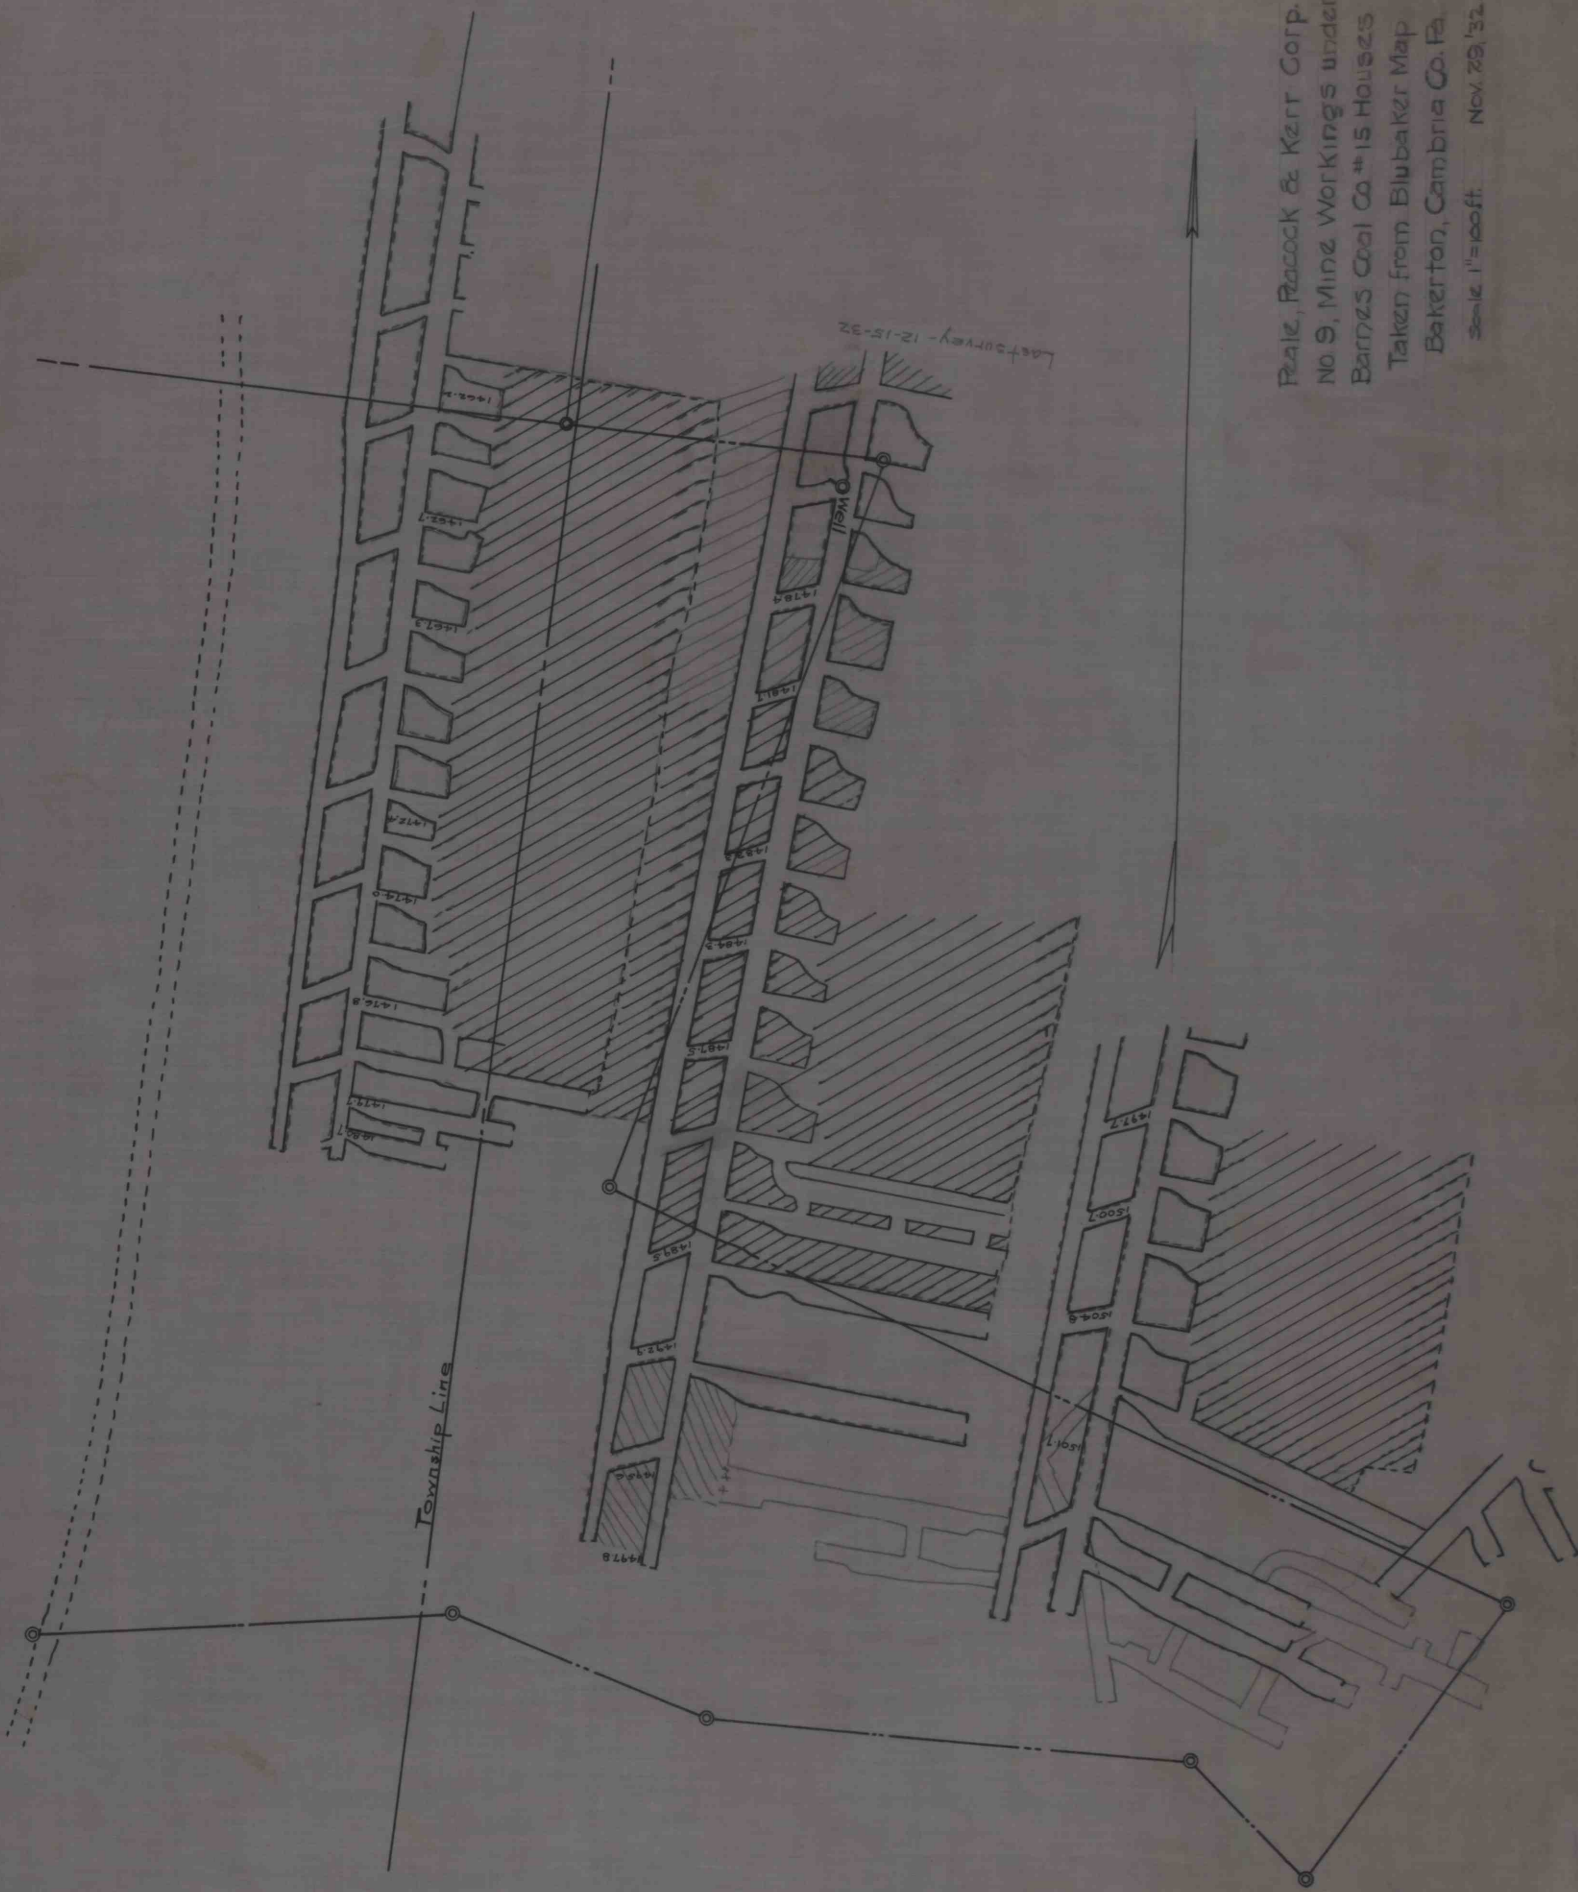

R-5455  
 R-4135