


R 5426

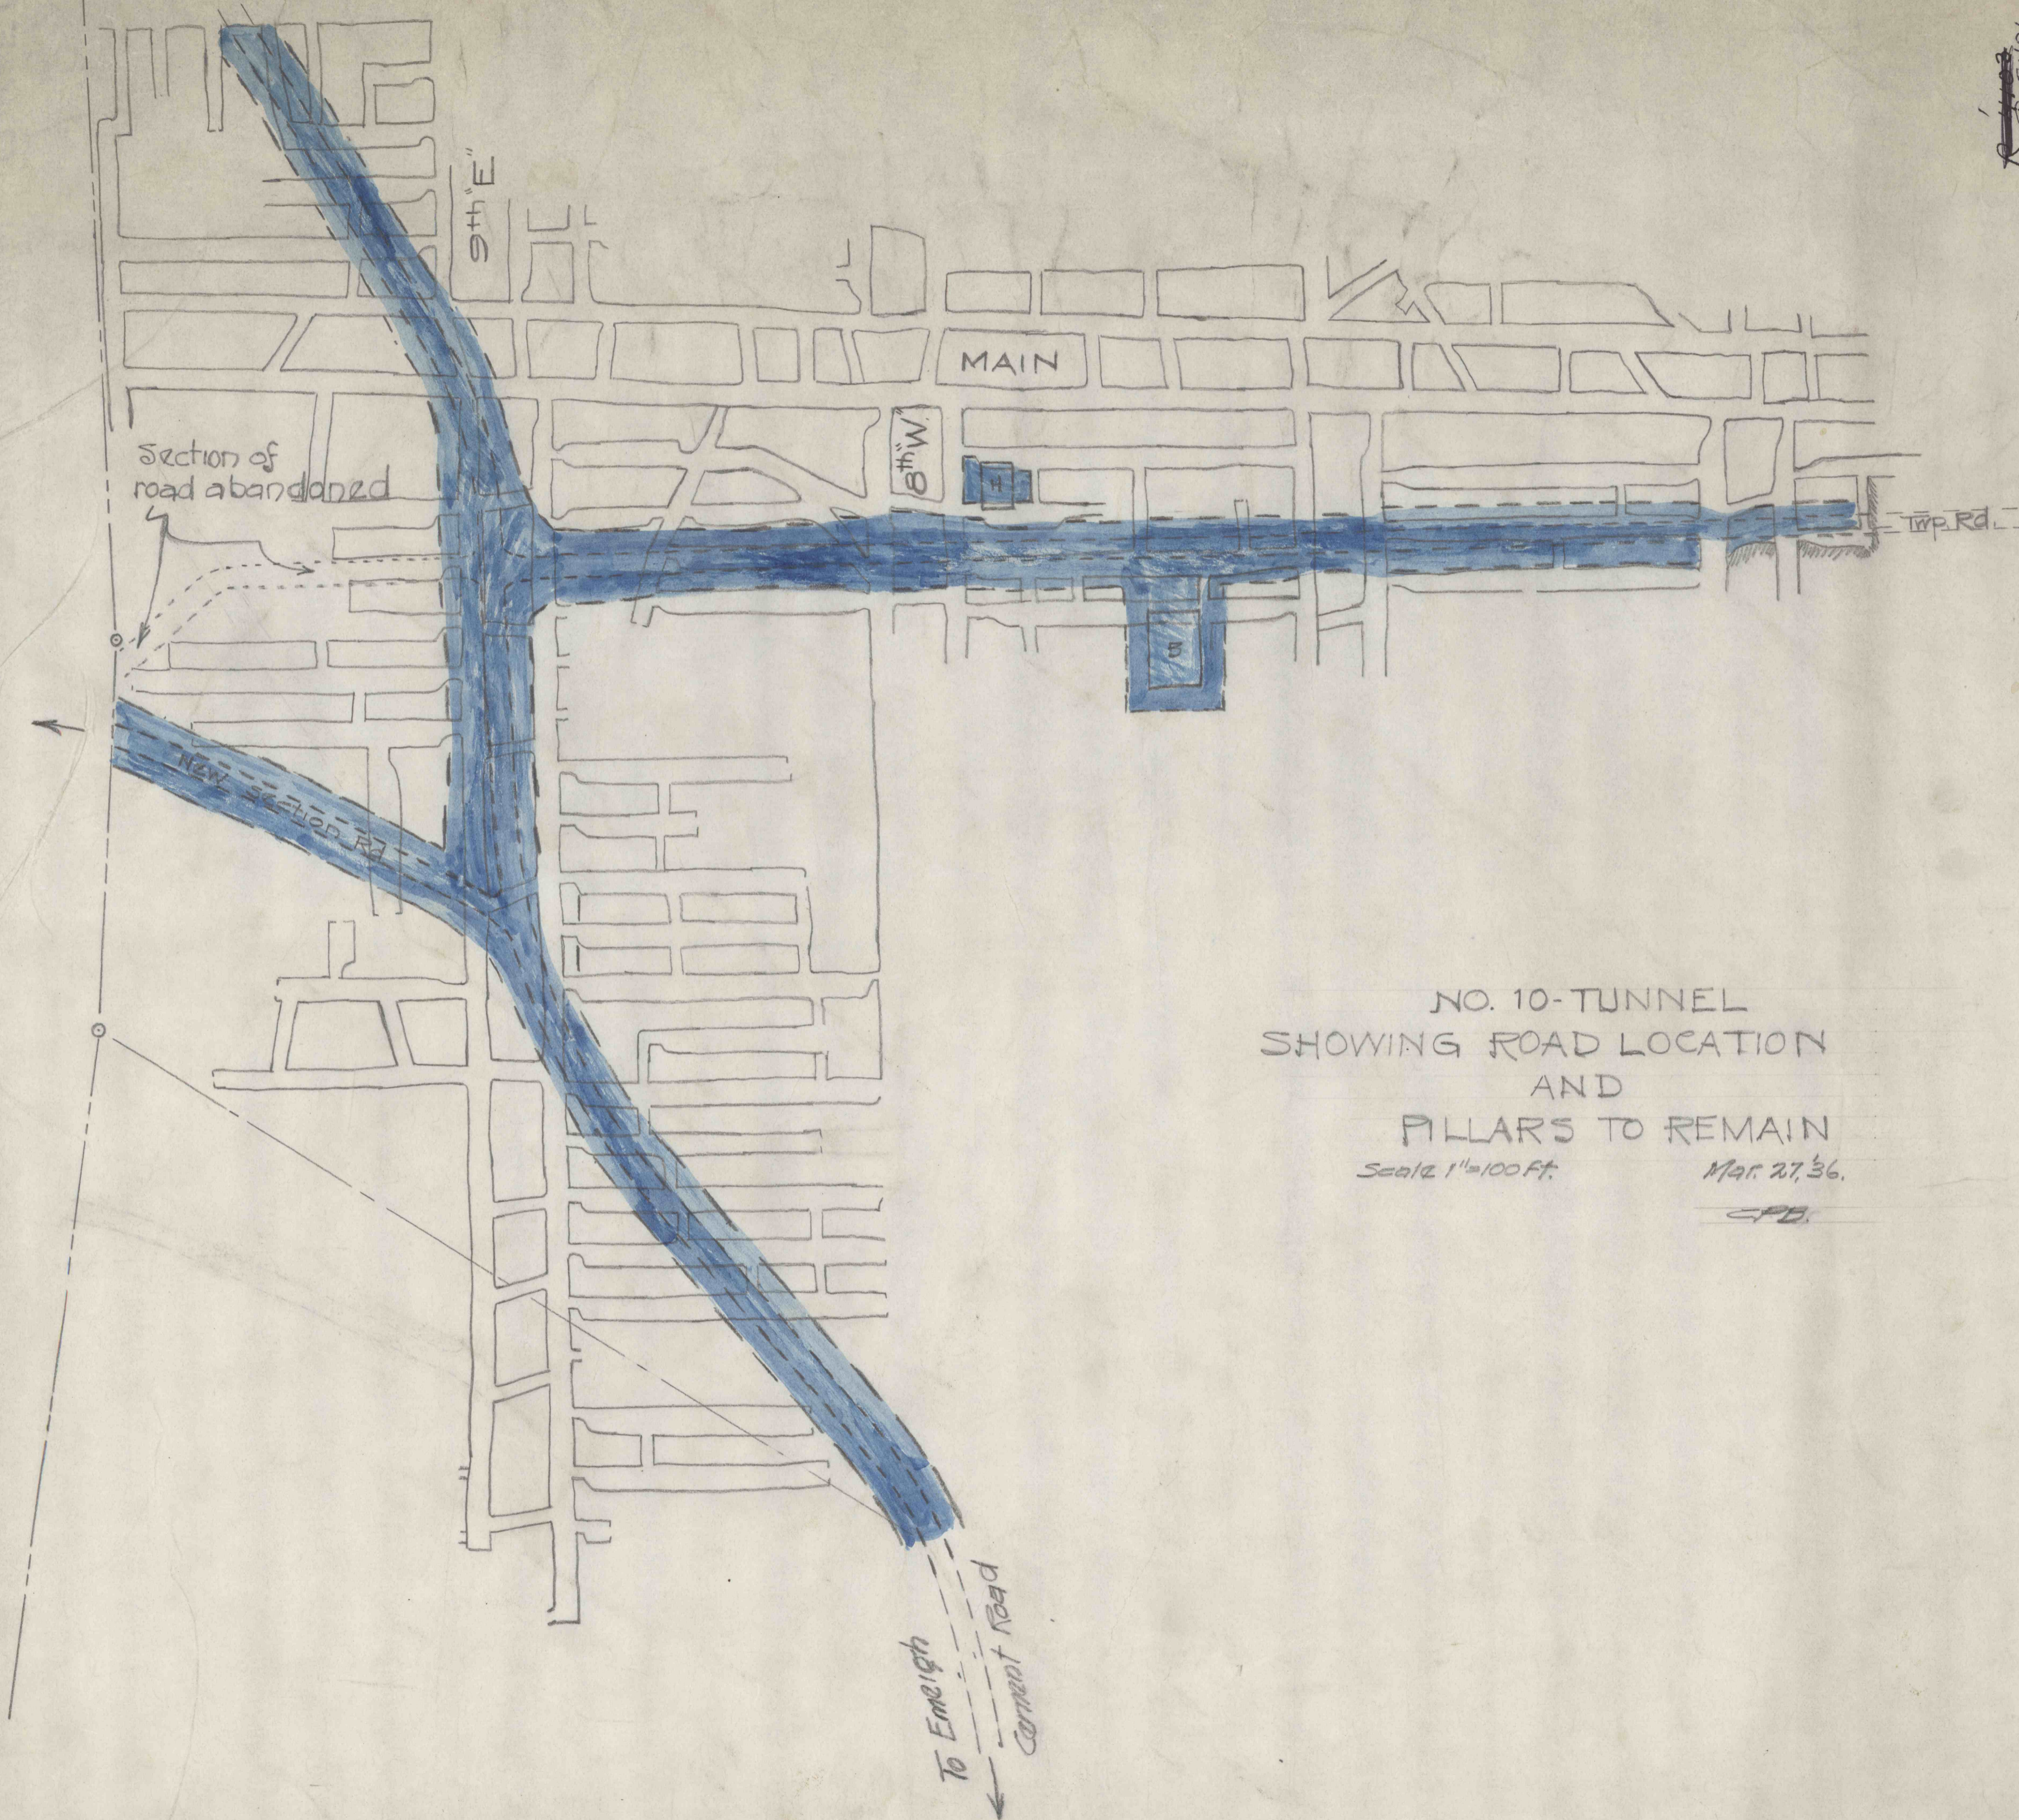

NO. 10-TUNNEL
 SHOWING ROAD LOCATION
 AND
 PILLARS TO REMAIN

Scale 1"=100 Ft.

Mar. 27, '36.

C.P.B.