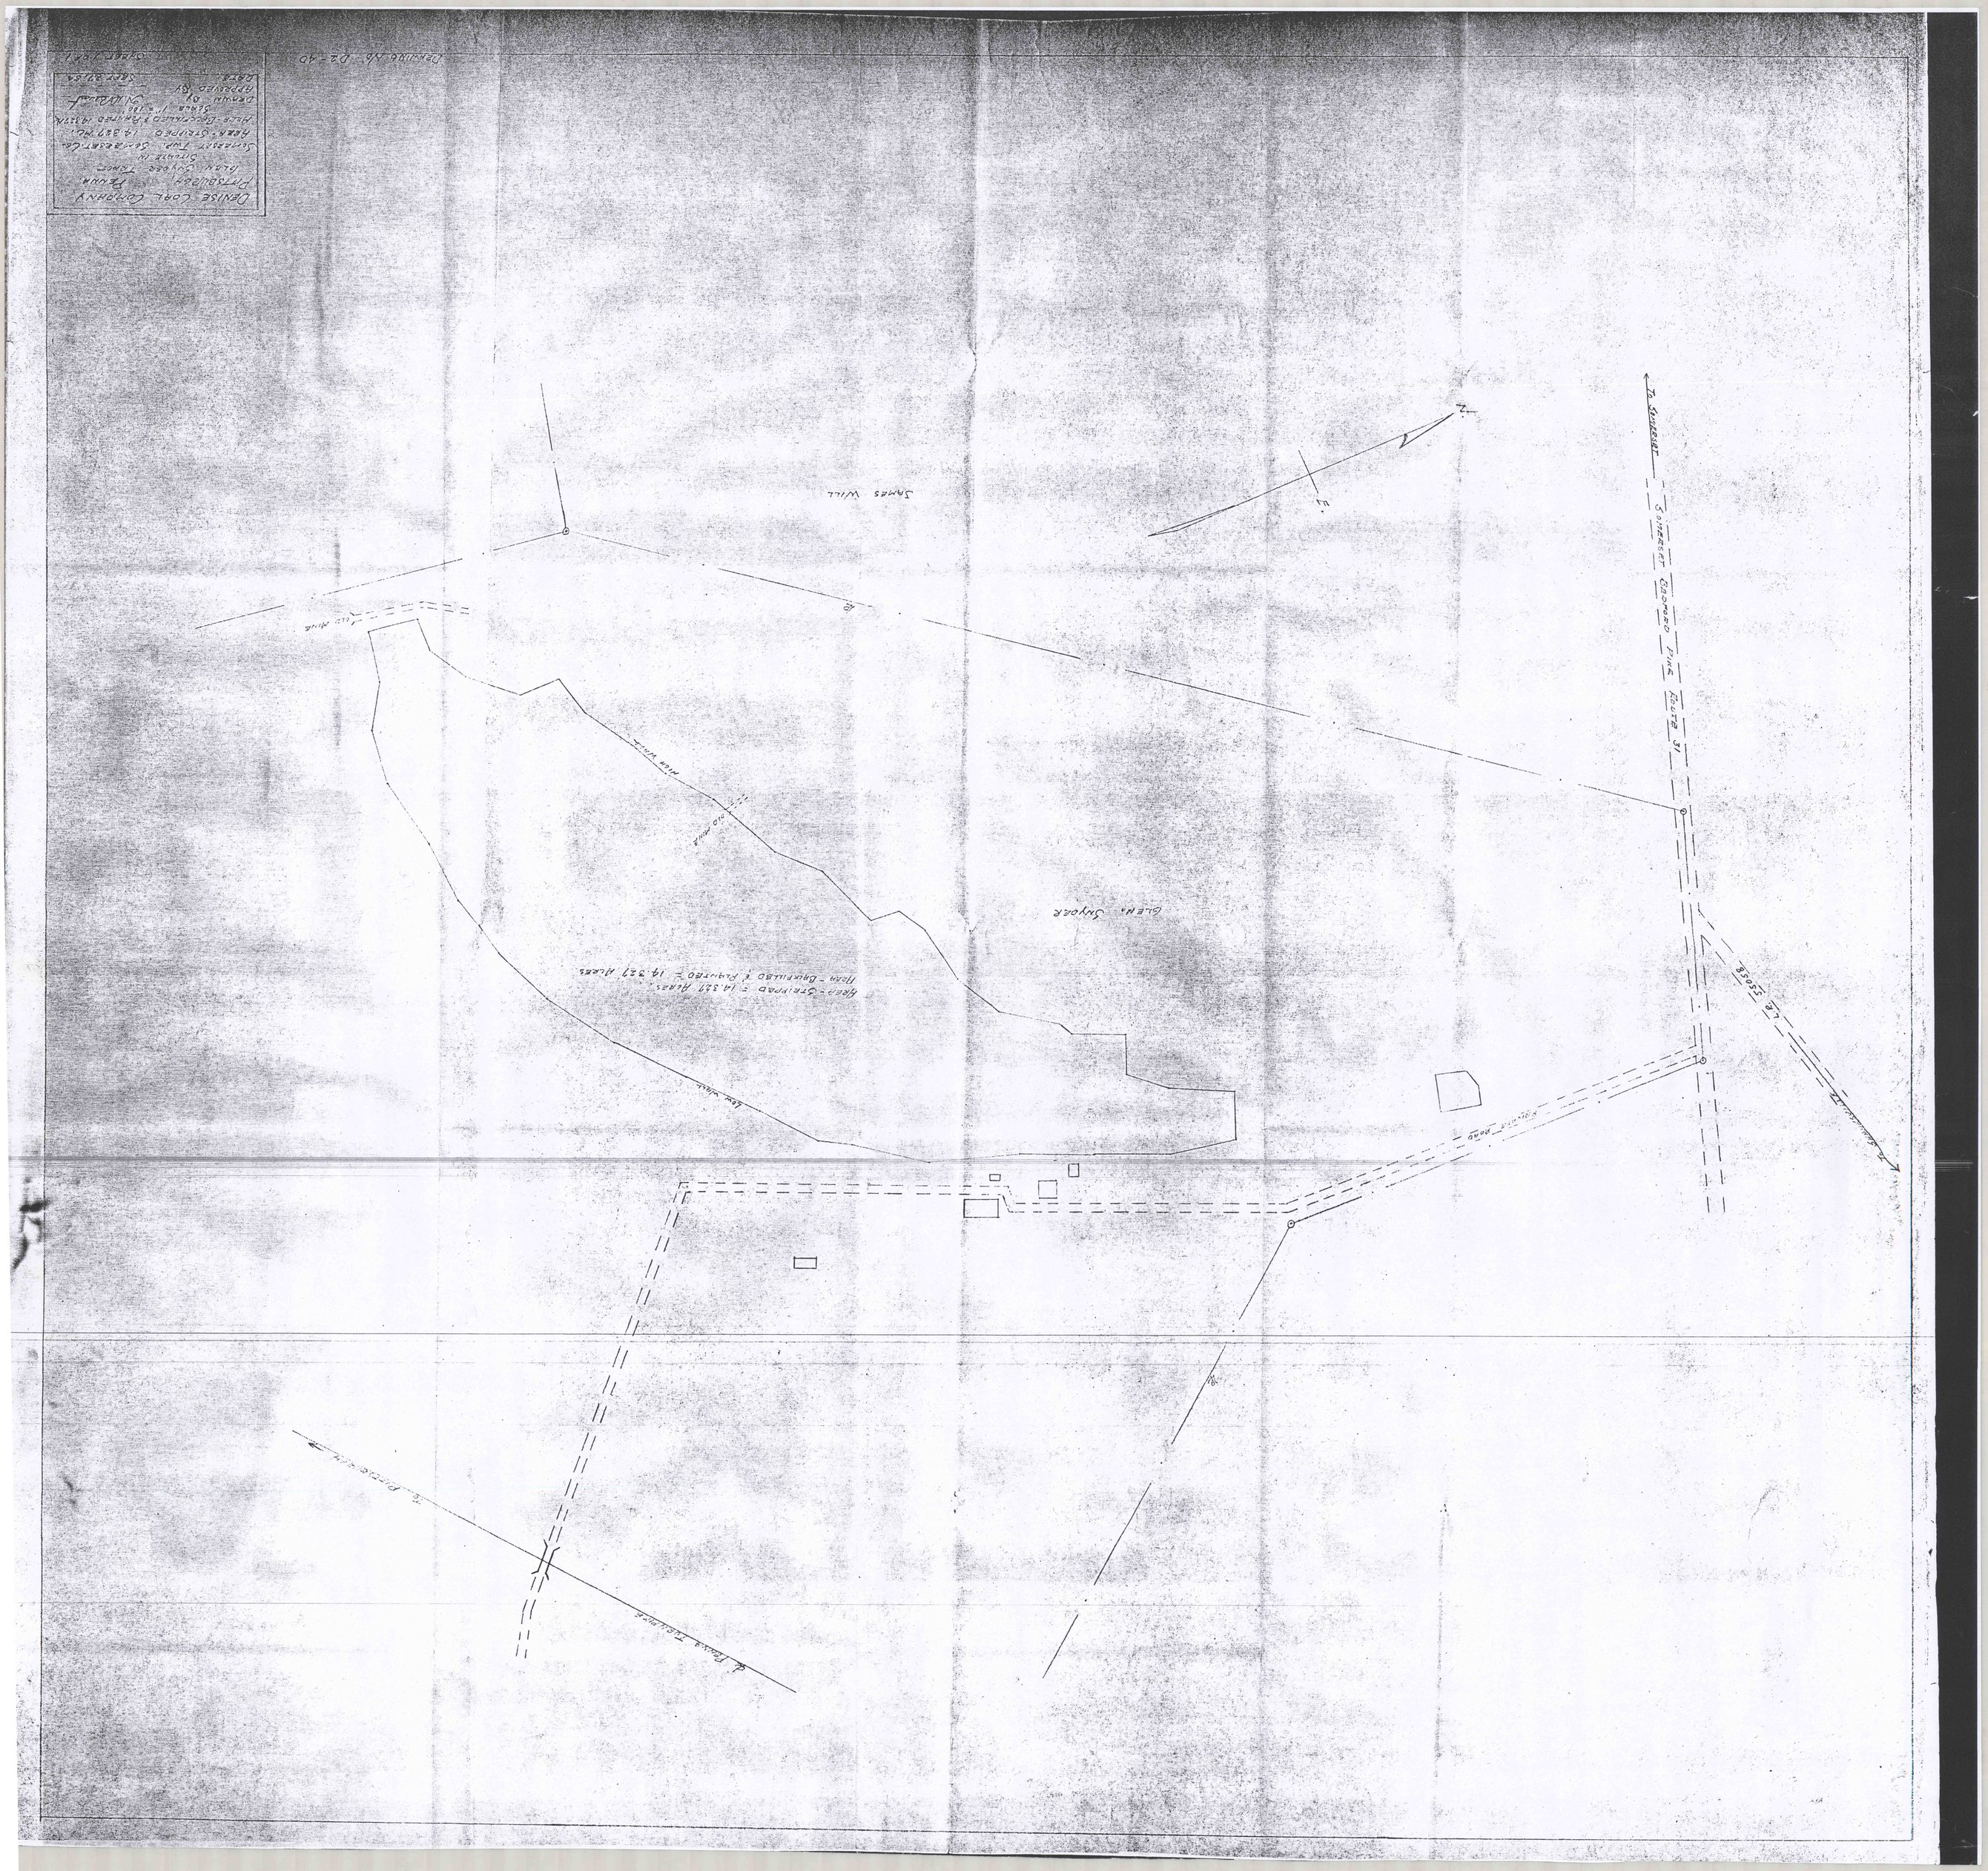
DENISE COAL COMPANY
PITTSBURGH, PENNA.
GLEN SNYDER TRACT
SOMERSET TWP. SOMERSET CO.
AREA-STRIPPED 14.327 AC.
AREA-BACKFILLED & PLANTED 14.327 AC.
SCALE 1" = 100'
DRAWN BY
APPROVED BY
DATE SEPT 27, 54
SHEET 1 OF 1
DRAWING No. D2-40
SAMES WILL
GLEN SNYDER
TO SOMERSET
SOMERSET BEDFORD PIKE ROUTE 31
LR 55058
TO PITTSBURGH
TO PENNA TURNPIKE
AREA-STRIPPED = 14.327 ACRES
AREA-BACKFILLED & PLANTED = 14.327 ACRES