


LEVI WALKER
NOW RINGLER

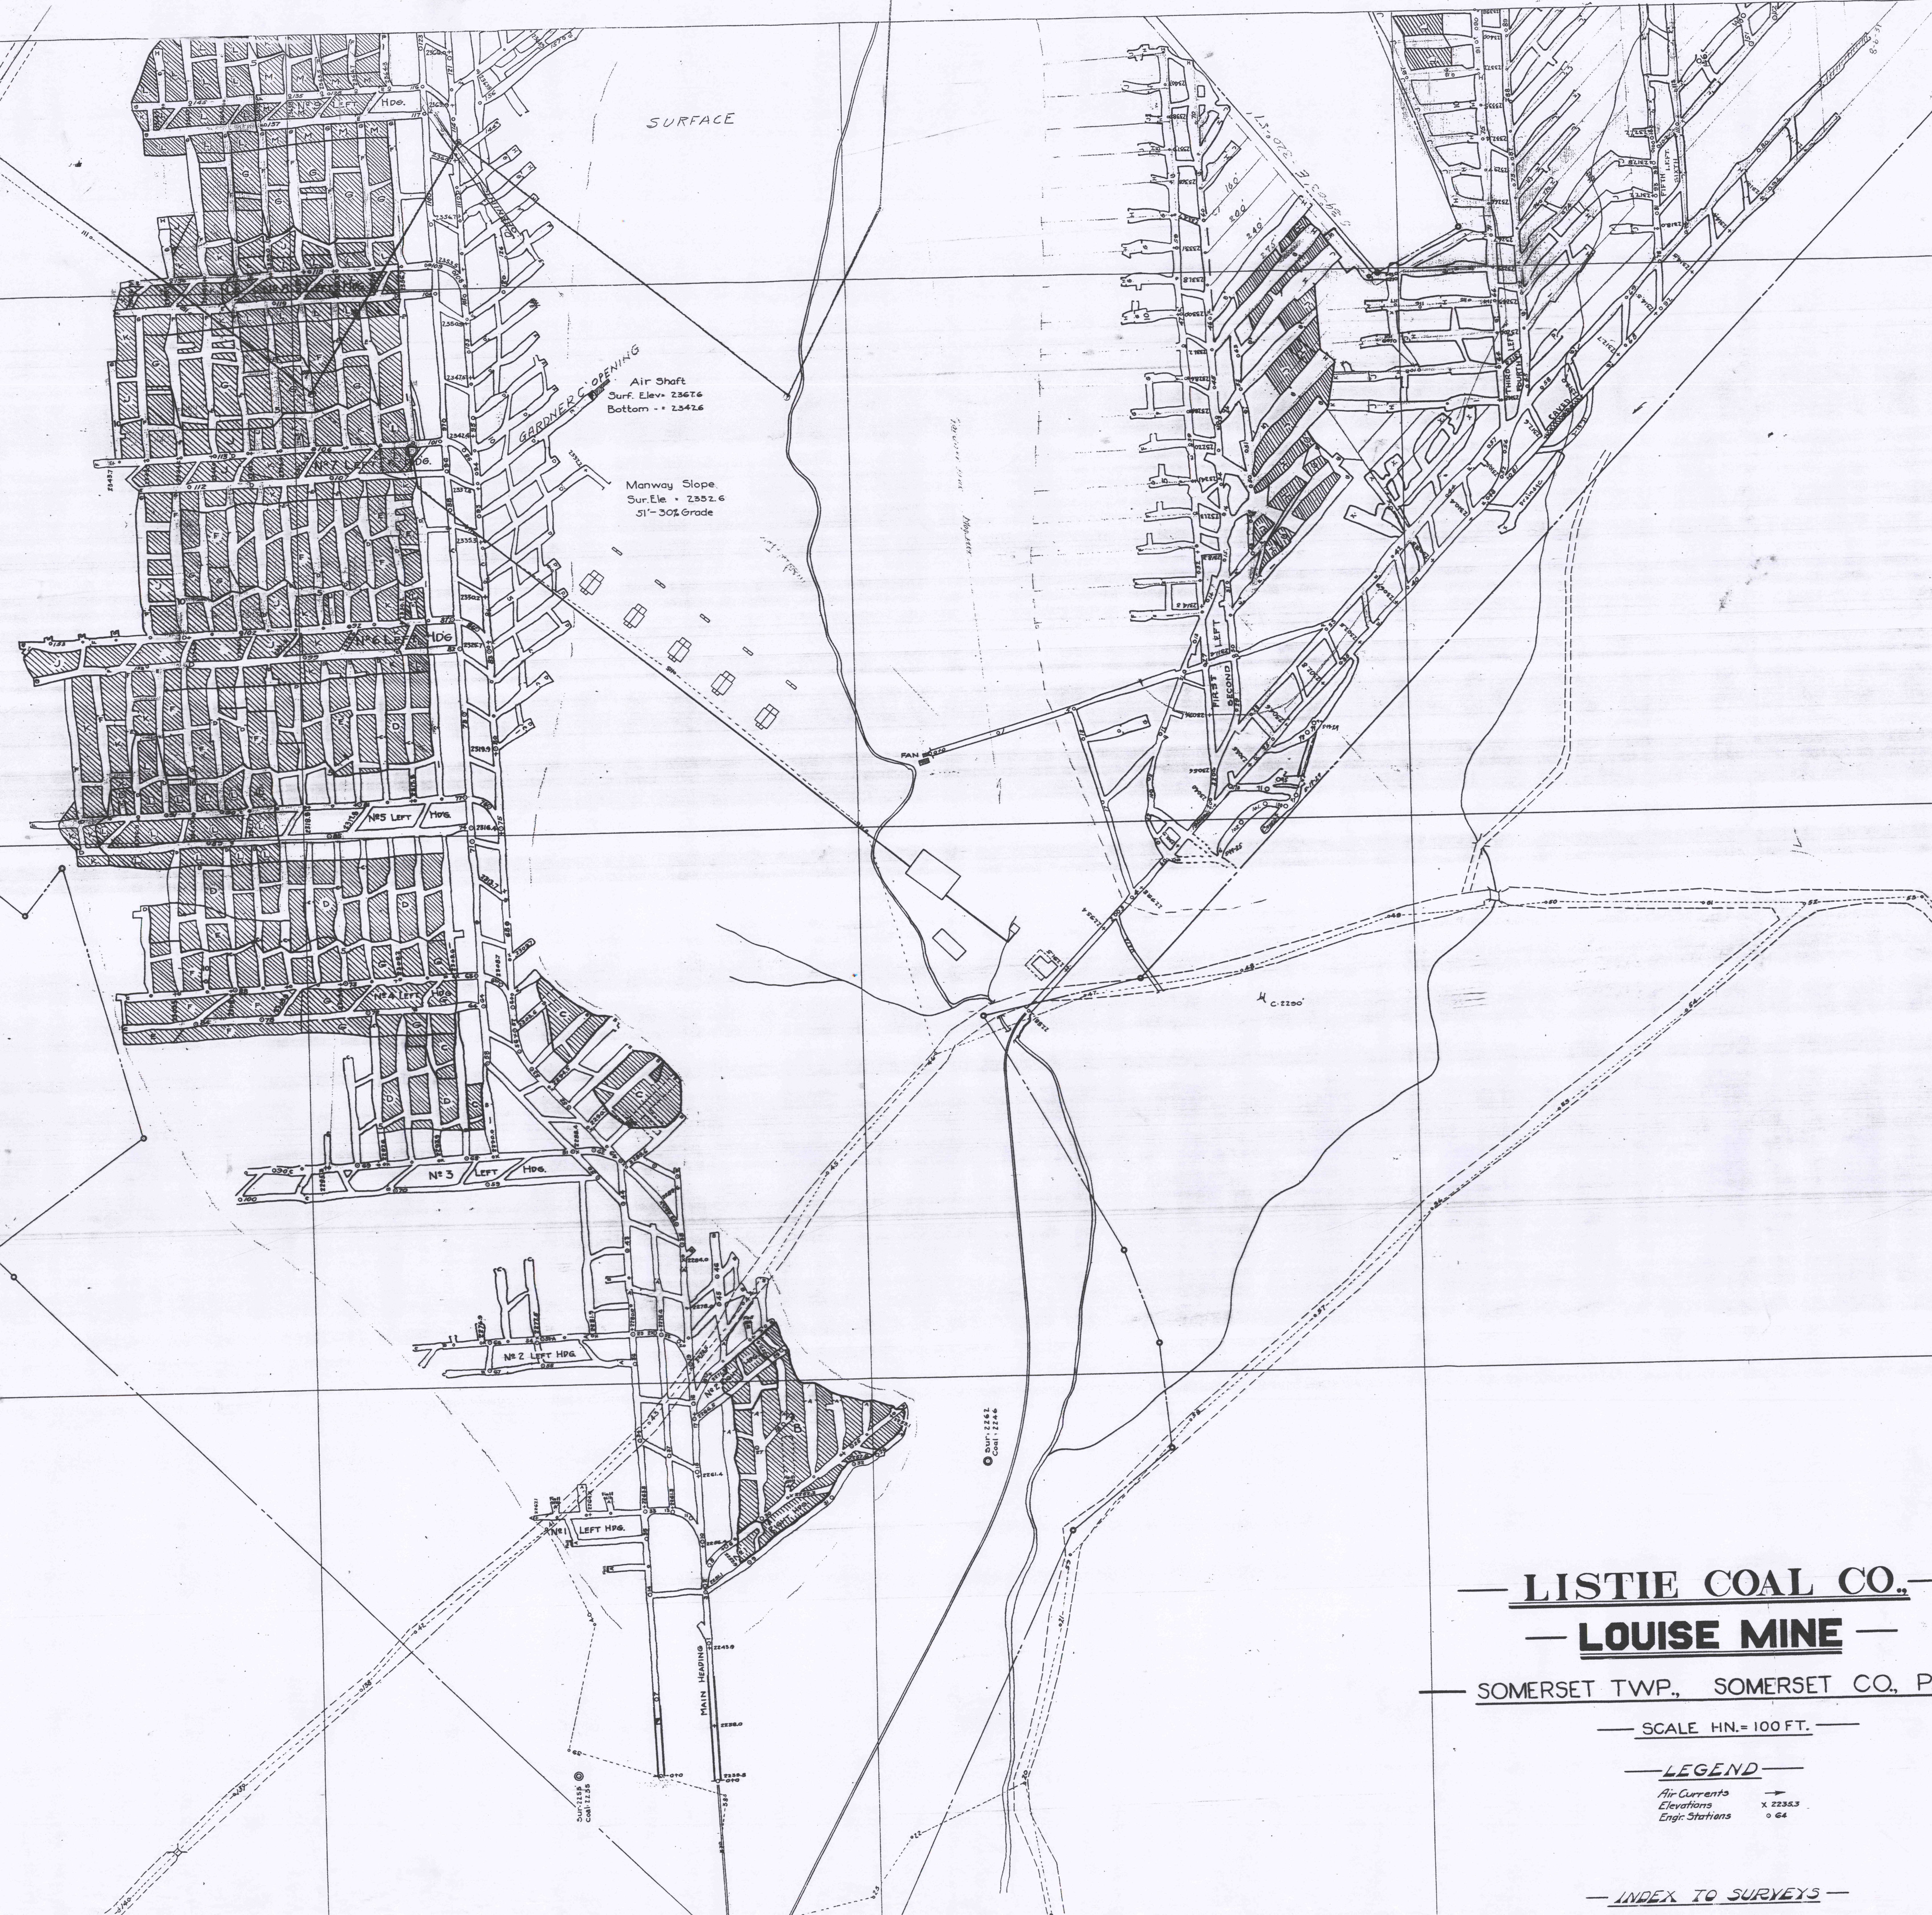

— LISTIE COAL CO. —
— LOUISE MINE —
— SOMERSET TWP., SOMERSET CO., PA. —

— SCALE HN. = 100 FT. —

— LEGEND —
Air Currents —
Elevations x 225.3
Engr. Stations o. 64

— INDEX TO SURVEYS —