

CENTER COAL CO MINE MAP

Situated in Jackson Twp.

Mercer County Pa.


Scale 1" = 100'

March 7, 1948

Dec. 18, 1949

W.S. Hines R.S.

- Nov. 19, 1950
- Jan. 8, 1951
- Apr. 2, 1951
- Nov. 2, 1952
- Mar. 7, 1954
- July 16, 1955
- Sept. 28, 1957
- Nov. 15, 1958

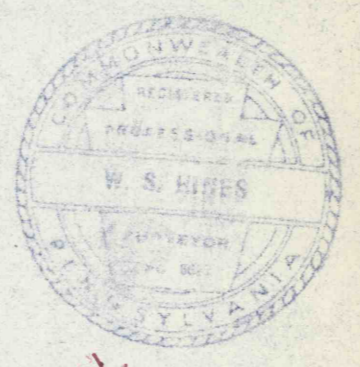



Proposed Future Deep Mining

Barrier Pillar