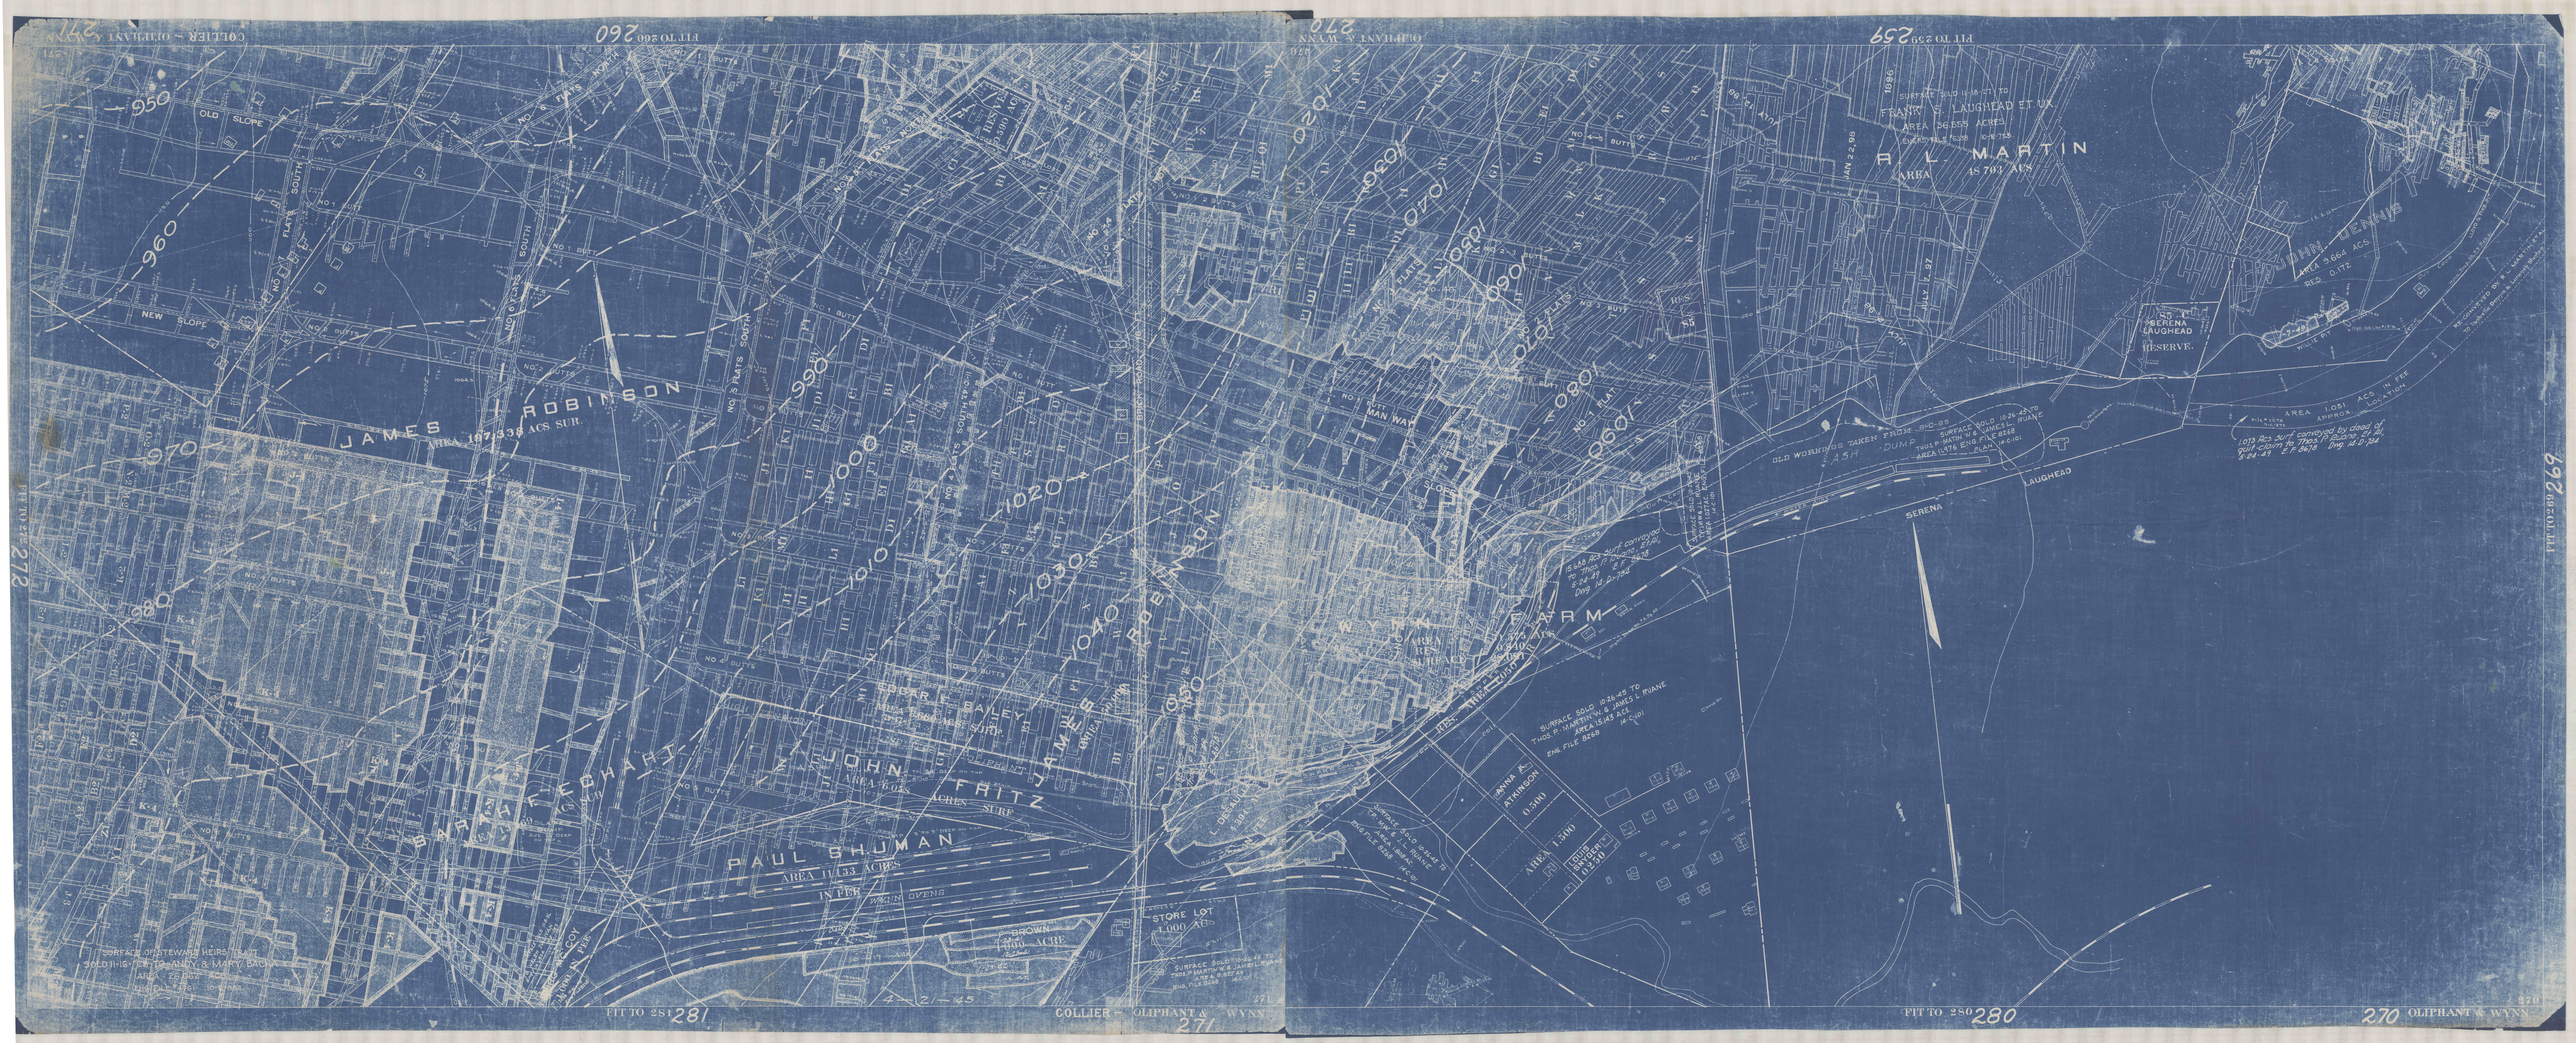
COLLIER ~ OLIPHANT & WYNN
FIT TO 260
FIT TO 259
FIT TO 272
FIT TO 269
FIT TO 281
FIT TO 280
JAMES ROBINSON
AREA 197.338 ACS. SUR.
BARBARA LEGHART
JOHN FRITZ
PAUL SHUMAN
AREA 11.133 ACRES
IN FEE
JAMES ROBINSON
R. L. MARTIN
AREA 48.701 ACS
FARM
SERENA LAUGHEAD RESERVE
OLD SLOPE
NEW SLOPE
NO 1 PLATS SOUTH
NO 2 PLATS SOUTH
NO 1 PLATS
MAIN WAY
OLD WORKINGS TAKEN FROM 1910-25
ASH DUMP
SERENA
LAUGHEAD
STORE LOT
1.000 AC
BROWN
1.800 ACRE
SERENA A. ATKINSON
0.500
AREA 1.300
LOUISE ATKINSON
0.500
SURFACE SOLD 8-26-49 TO
THOS. P. MARTIN & JAMES L. RUANE
AREA 15.143 ACS
ENG. FILE 8268
AC-C101
SURFACE SOLD 11-16-1911 TO
FRANK G. LAUGHEAD ET UX
AREA 36.555 ACRES
ENG. FILE 8268
AREA 9.664 ACS
REC. 0.172
AREA 1.081 ACS. IN FEE
APPROX. LOCATION
1013 Acs. Surf. conveyed by deed of gift. Conv. to Thos. P. Martin et al. 9-26-49 E.P. 8618 Dwg. 48-D-134