


BUTLER CONSOLIDATED COAL CO.
WILDWOOD, PA.

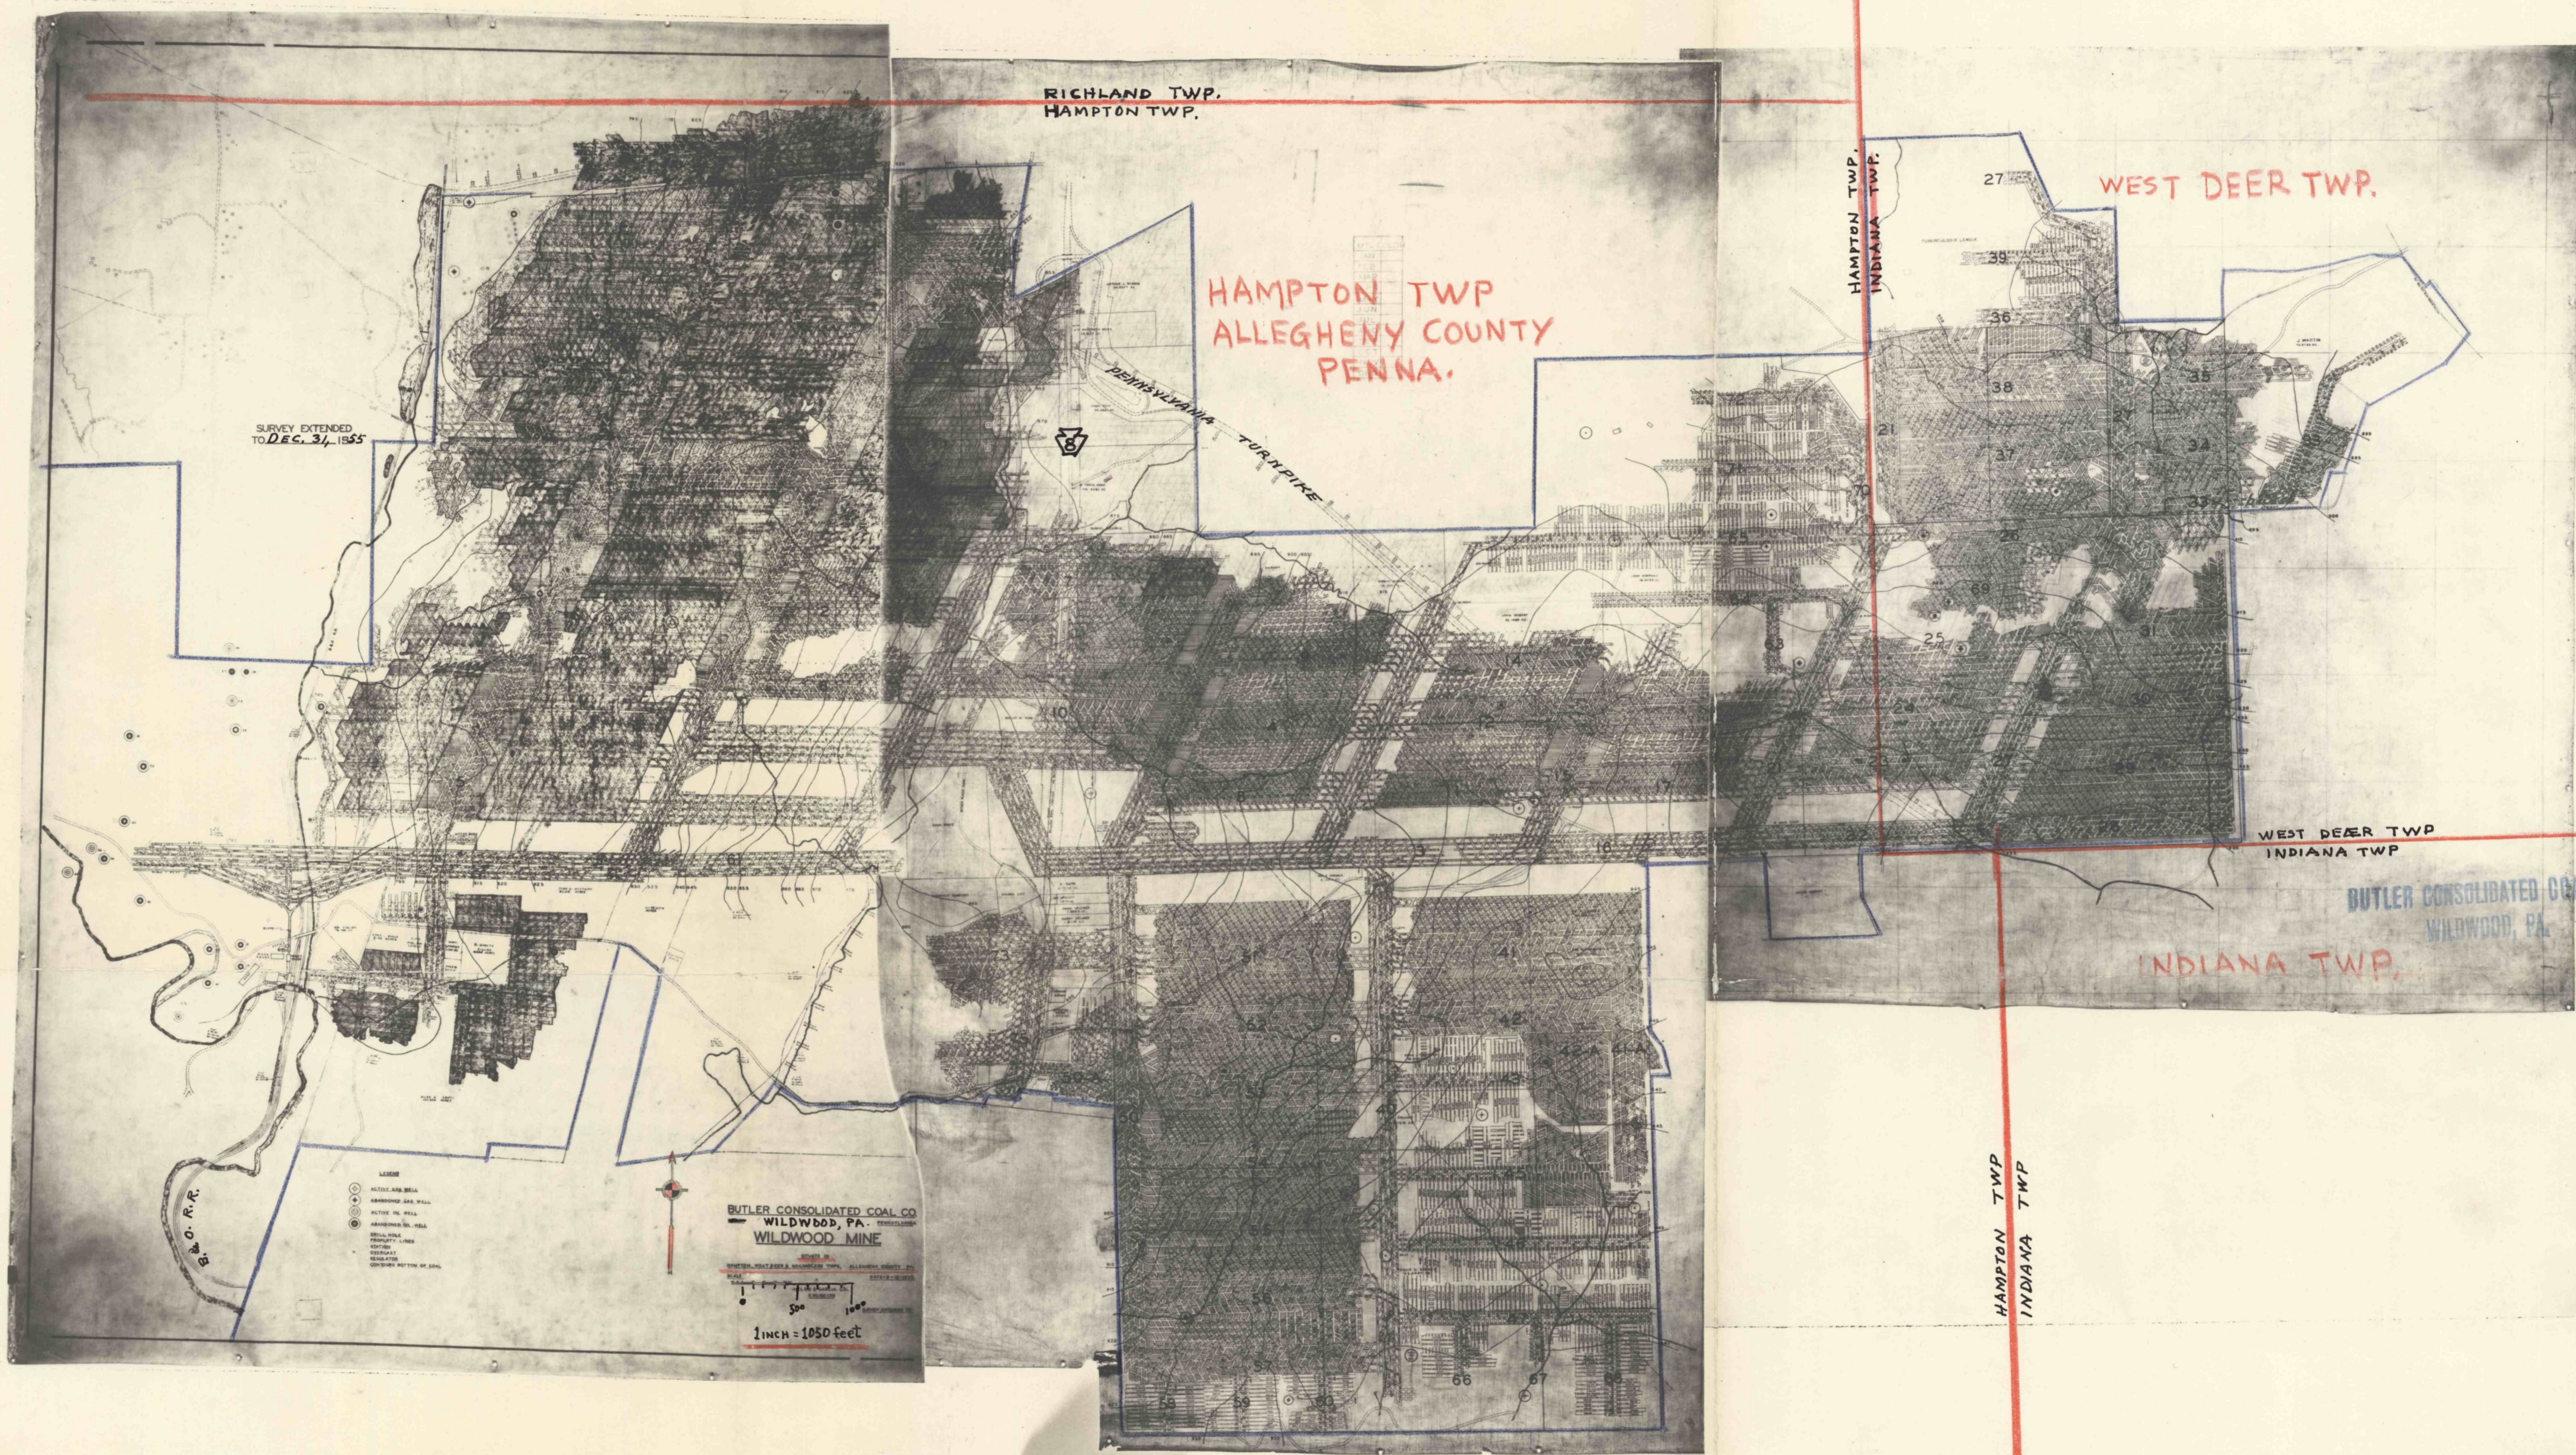

McCandias
Twp.

RICHLAND TWP.
HAMPTON TWP.

HAMPTON TWP
ALLEGHENY COUNTY
PENNA.

WEST DEER TWP.

HAMPTON TWP.
INDIANA TWP.

WEST DEER TWP
INDIANA TWP

BUTLER CONSOLIDATED COAL CO.
WILDWOOD, PA.

INDIANA TWP.

HAMPTON TWP
INDIANA TWP

BUTLER CONSOLIDATED COAL CO.
WILDWOOD, PA.

BUTLER CONSOLIDATED COAL CO.
WILDWOOD, PA.

15' New Kensington