#1832
12-17-99
CO

DETAILED ENLARGEMENT OF Nº 16 LEFT OFF Nº 2 DIP
MONROE C. M. CO. REVLOC, PA.

SCALE 1" = 10'

MARCH-13-41

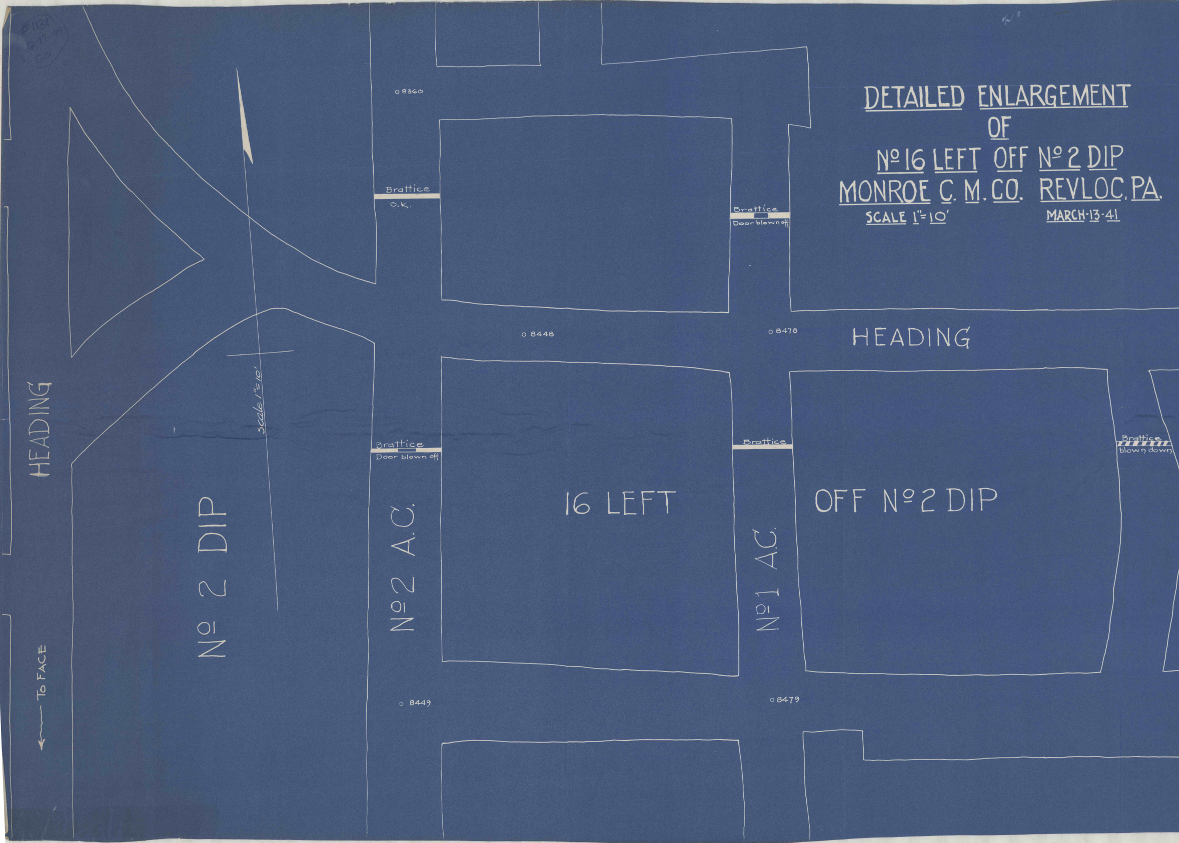

o 8360
Brattice
O.K.
Brattice
Door blown off
o 8448
o 8478
HEADING
HEADING
scale 1" = 10'
Brattice
Door blown off
Brattice
Brattice
blown down
Nº 2 DIP
Nº 2 A.C.
16 LEFT
Nº 1 A.C.
OFF Nº 2 DIP
To FACE
o 8449
o 8479

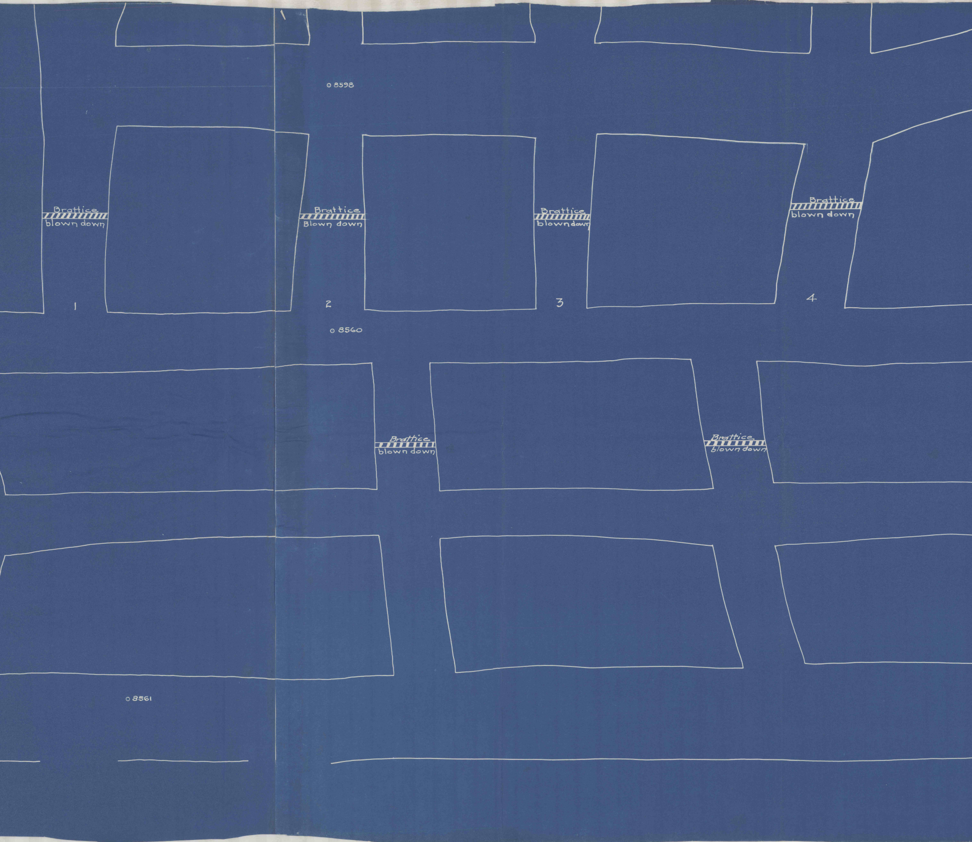
o 8598
Brattice blown down
Brattice Blown down
Brattice blown down
Brattice blown down
1
2
3
4
o 8560
Brattice blown down
Brattice blown down
o 8561

08734

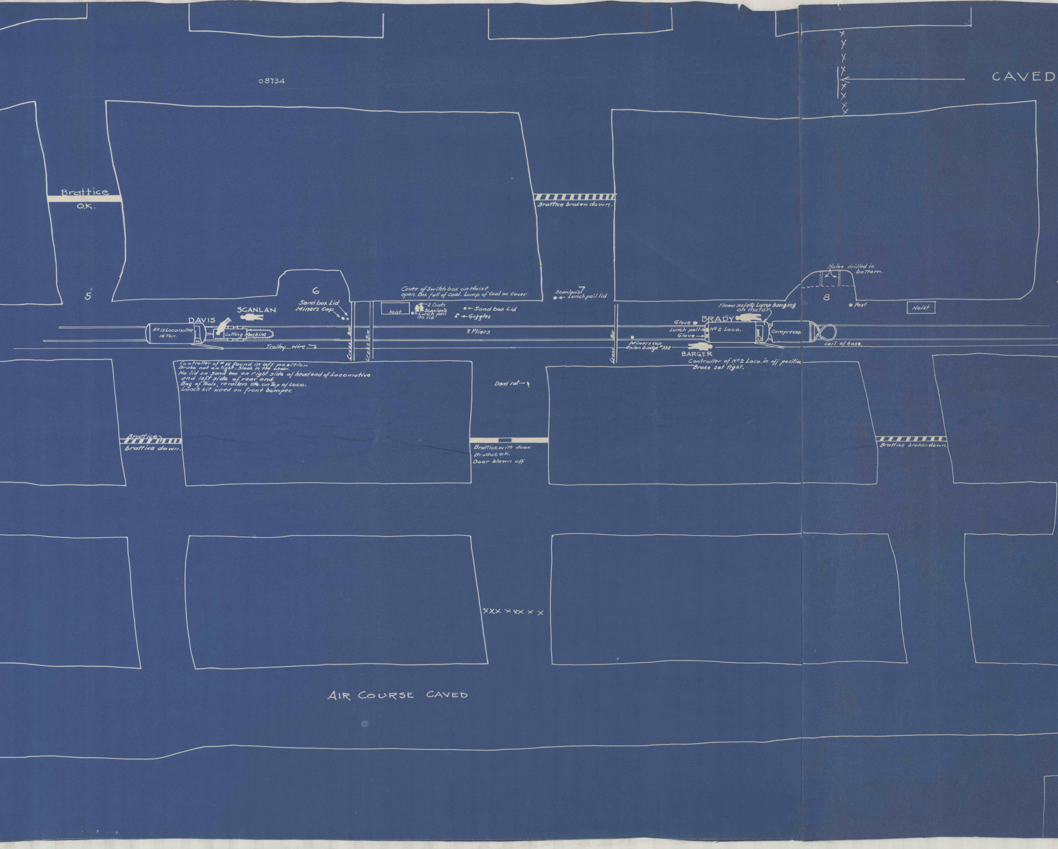
CAVED
Brattice
O.K.
Brattice broken down.
5
6
7
8
Holes drilled in bottom.
Cover of Switch box on Hoist open. Box full of coal. Lump of Coal on Cover.
Scanlan's Lunch pail lid
Sand box Lid
Miners Cap
SCANLAN
DAVIS
Nº 15 Locomotive 10 Ton.
Cutting Machine
Trolley wire
Cross Bar
Cross Bar
Hoist
2 Coats
Scanlan's Lunch pail no lid
Sand box Lid
Goggles
Pliers
Cross Bar
Flame safety Lamp hanging on motor
Glove
BRADY
Lunch pail
Nº 2 Loco.
Glove
Compresso
Miners cap Union badge #332
BARGER
coil of hose.
Post
Hoist
Dead rat
Brattice
brattice down.
Brattice with door.
Brattice OK.
Door blown off.
Brattice broken down.
XXX XXX X X
AIR COURSE CAVED

Controller of #15 found in off position
Brake not on tight. Slack in the chain.
No lid on sand box on right side of head end of Locomotive
and left side of rear end.
Bag of Tools, rerailers etc. on top of Loco.
Lunch kit wired on front bumper.

Controller of Nº 2 Loco. in off positio
Brake set tight.

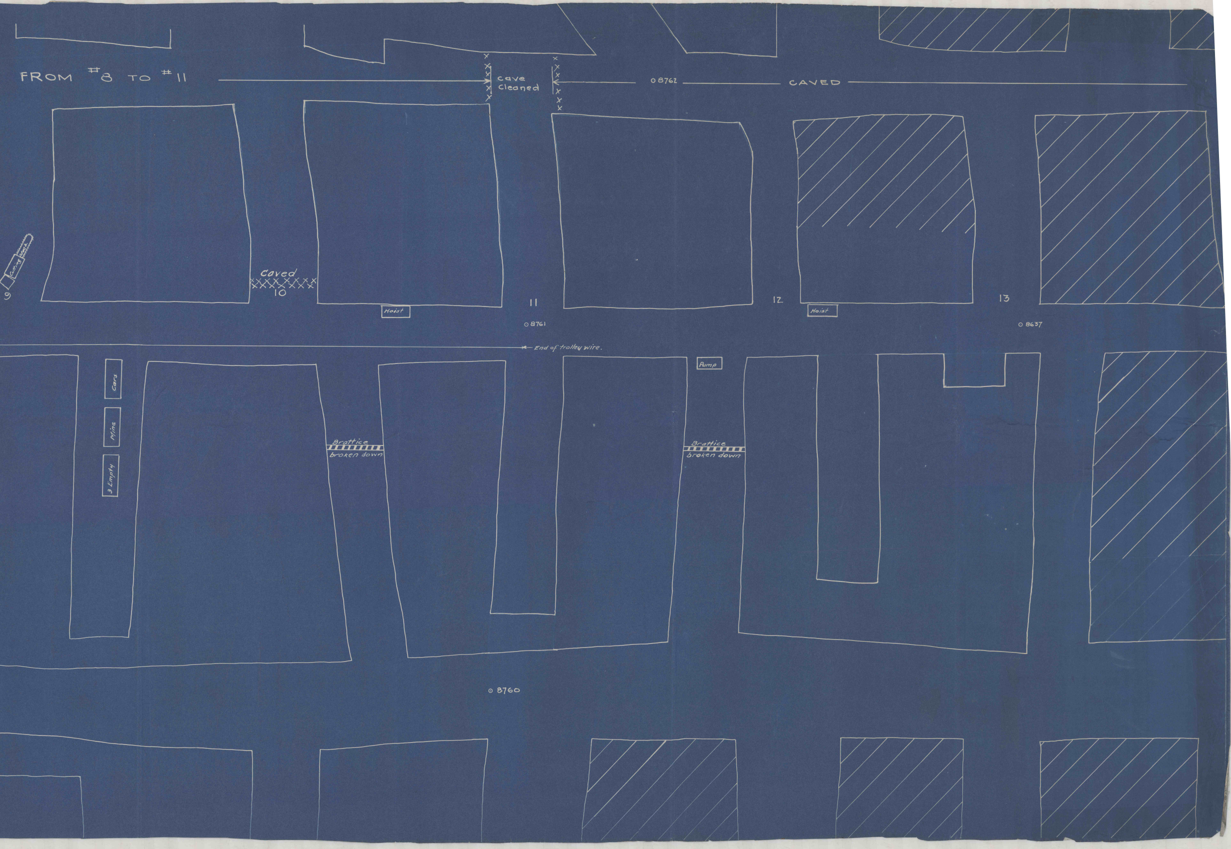
FROM #8 TO #11
cave cleaned
o 8762
CAVED
Cutting Mach.
9
Caved
10
11
12
13
Hoist
Hoist
o 8761
o 8637
End of trolley wire.
Pump
Cars
Mine
3 Empty
Brattice broken down
Brattice broken down
o 8760