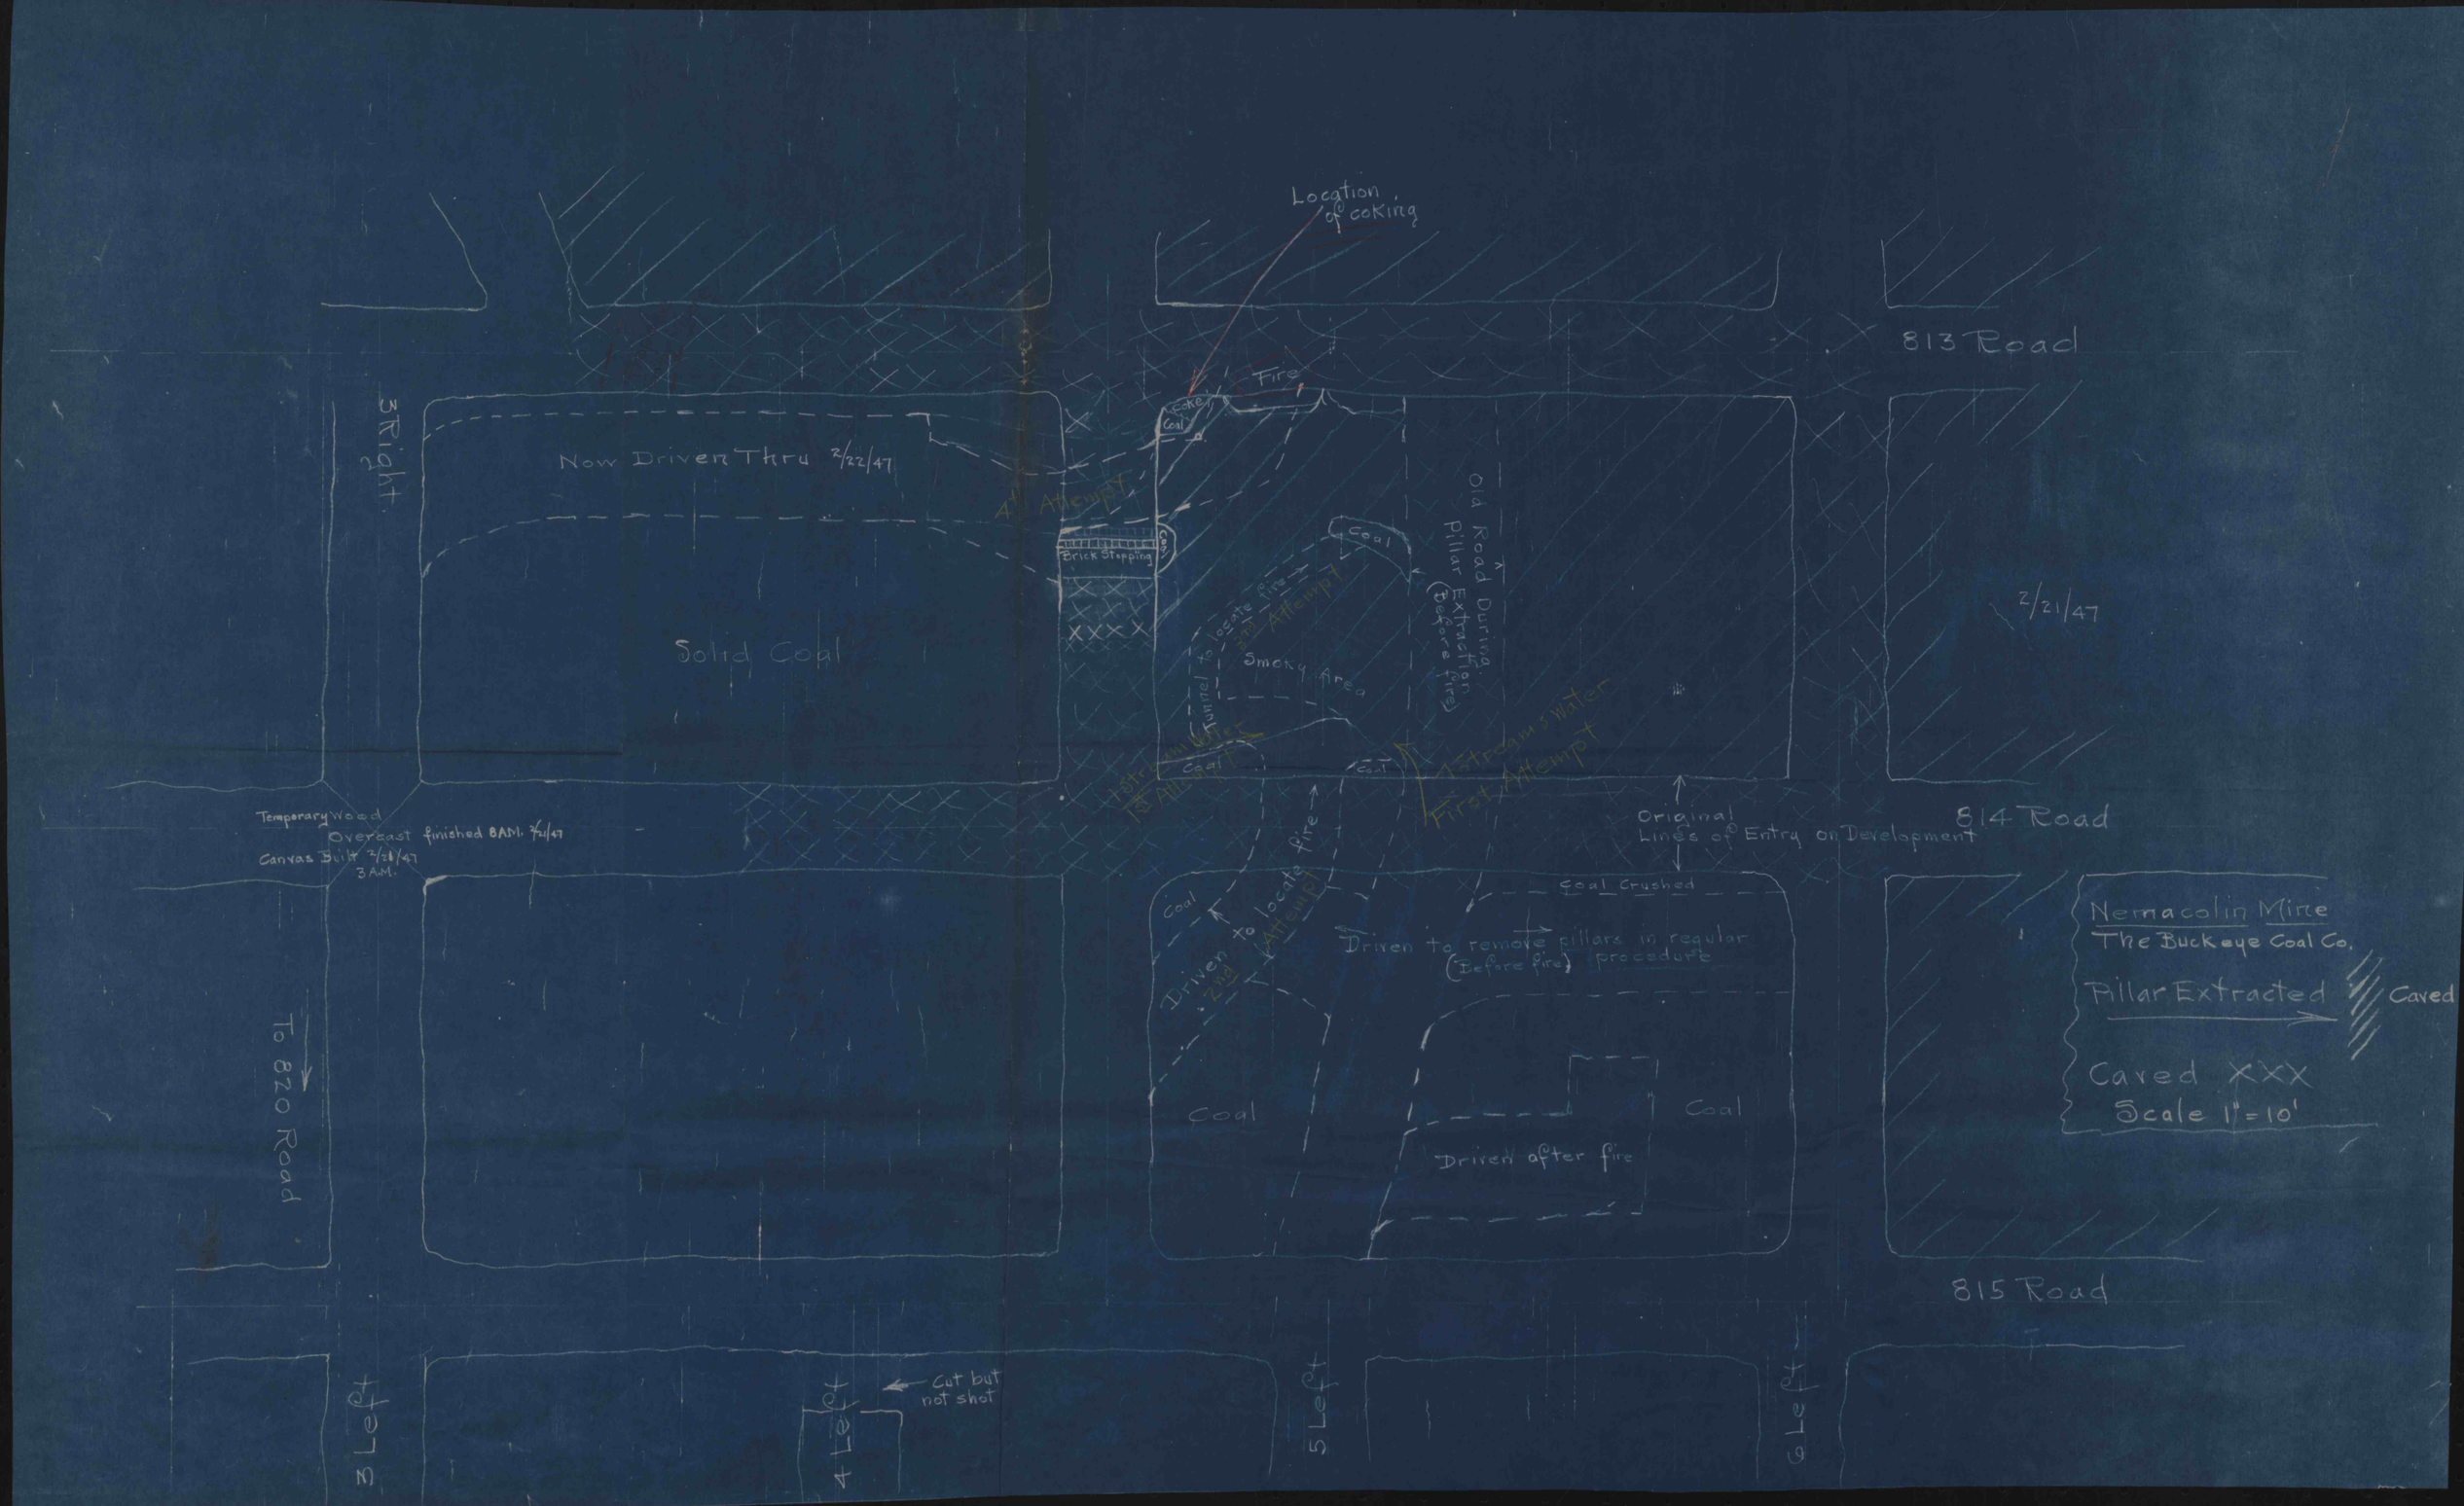

Location of coking
813 Road
Fire
Coke
Coal
3 Right
Now Driven Thru 2/22/47
4th Attempt
Brick Stopping
Coal
Old Road During Pillar Extraction (Before fire)
Coal
Tunnel to locate fire
3rd Attempt
Smoky Area
Solid Coal
2/21/47
Coal
Coal
1st Attempt
First Attempt
Temporary Wood
Overcast finished 8 A.M. 2/21/47
Canvas Built 2/21/47 3 A.M.
Original Lines of Entry on Development
814 Road
Coal
Driven to locate fire
2nd Attempt
Coal Crushed
Driven to remove pillars in regular procedure (Before fire)
Nemacolin Mine
The Buckeye Coal Co.
Pillar Extracted
Caved
Caved XXX
Scale 1" = 10'
To 820 Road
Coal
Coal
Driven after fire
815 Road
3 Left
4 Left
Cut but not shot
5 Left
6 Left