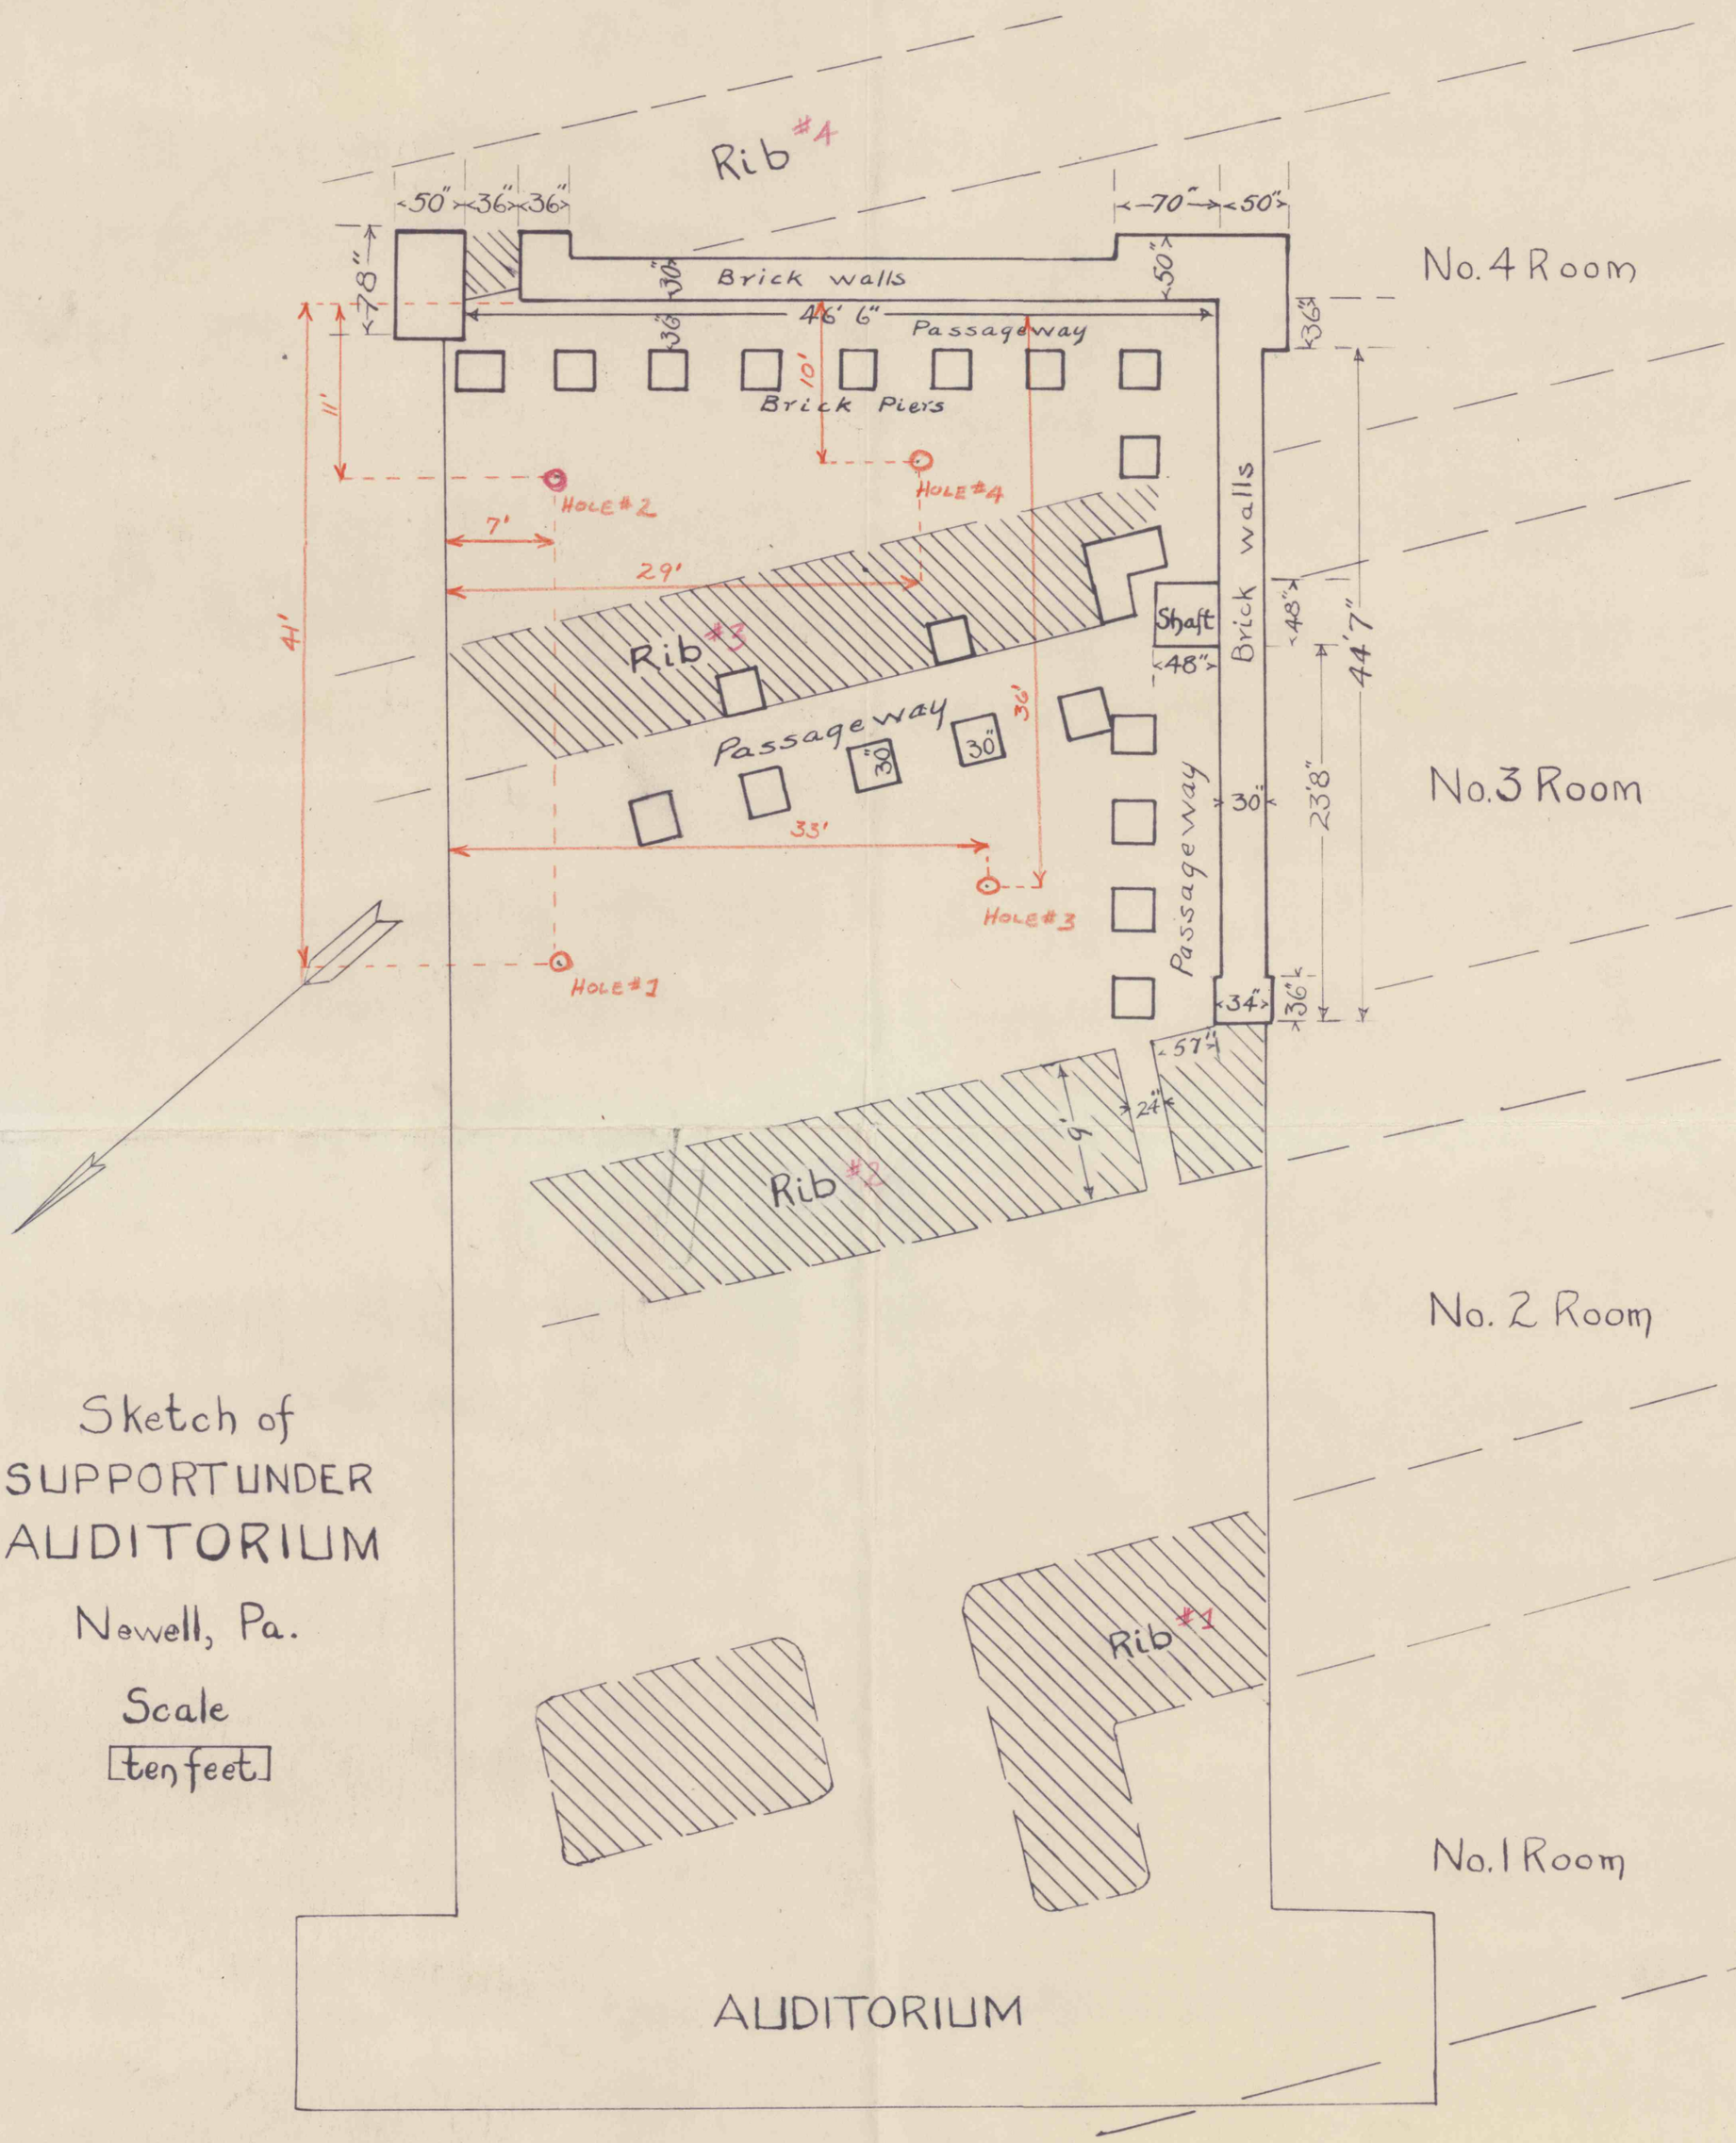

Sketch of
SUPPORT UNDER
AUDITORIUM

Newell, Pa.

Scale
[ten feet]

Ref. j