


COAL MINE OF

H. J. BATSCHELET

RENOVA, PA.

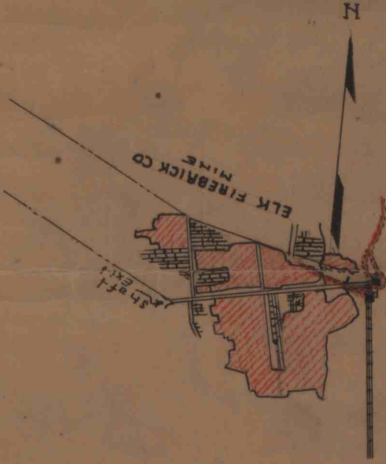

--- PROP. LINE

--- Road

— Pit Mouth

☒ Tipple

▨ Mined Out

== Railroad

LOWER KITTIMING SEAM
CLINTON COUNTY

SCALE 1200 ft = 1 in.

Reduced 2-28-36 F.S.M.

Probably Bitumen Quad # 6 or 9