
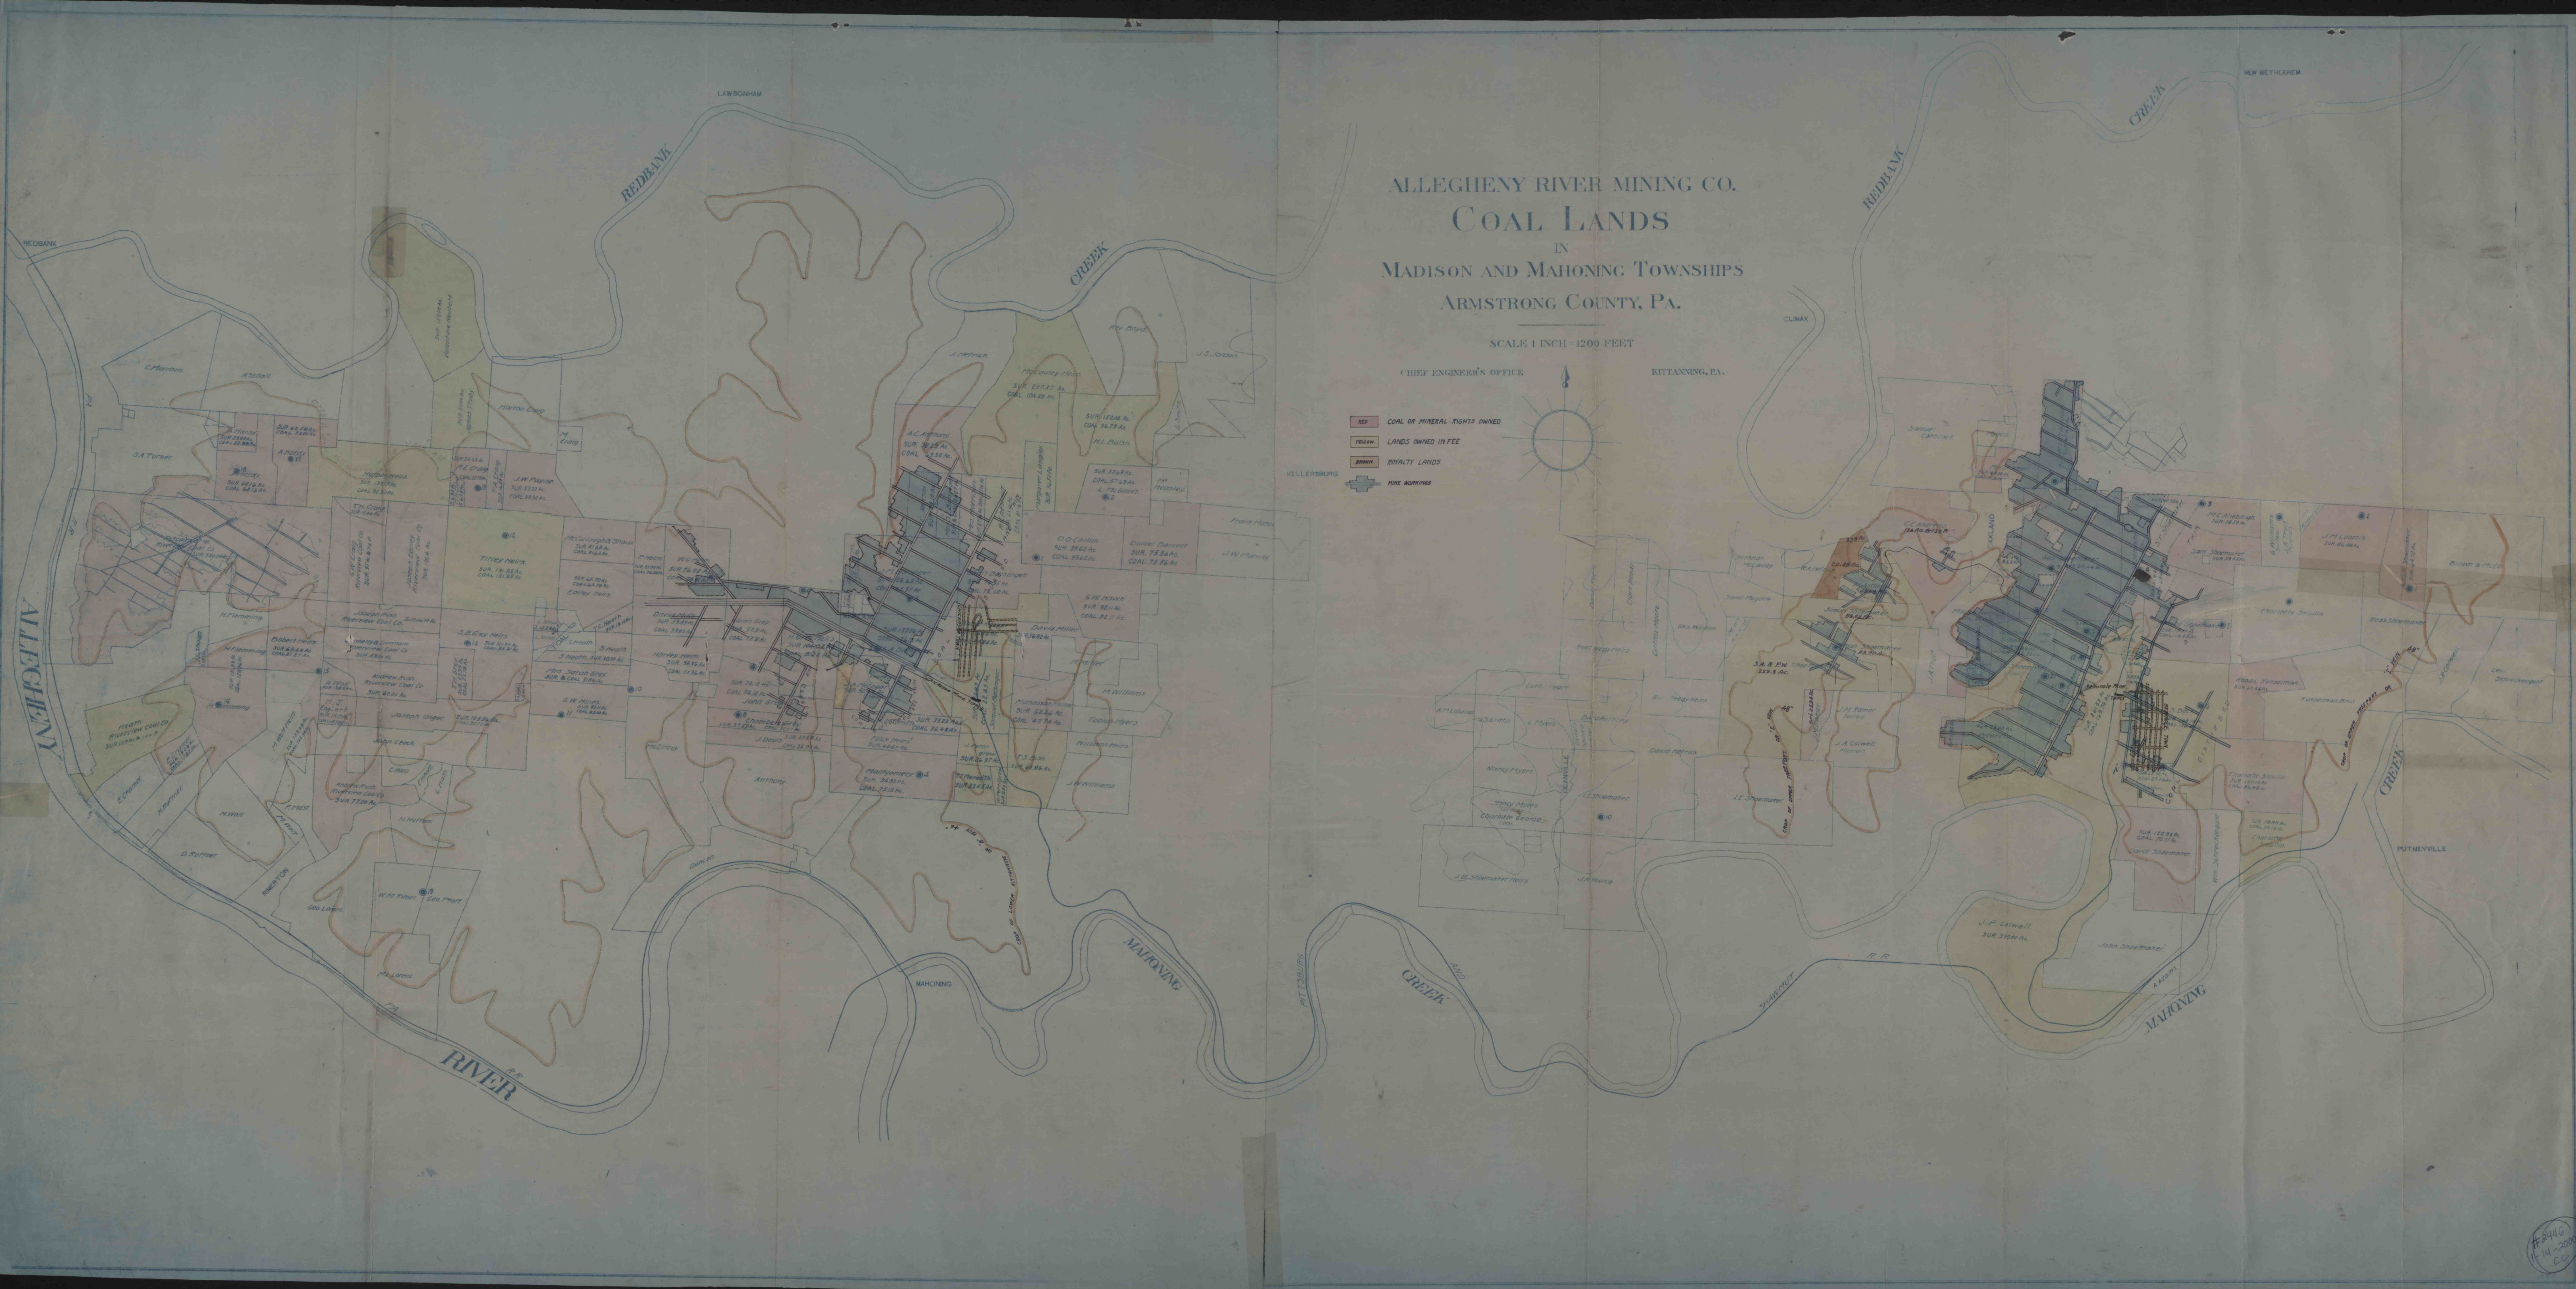


ALLEGHENY RIVER MINING CO.
COAL LANDS
IN
MADISON AND MAHONING TOWNSHIPS
ARMSTRONG COUNTY, PA.

SCALE 1 INCH = 1200 FEET

CHIEF ENGINEER'S OFFICE
RITTANNING, PA.

- RED COAL OR MINERAL RIGHTS OWNED
- YELLOW LANDS OWNED IN FEE
- BROWN ROYALTY LANDS
- MINING WORKINGS

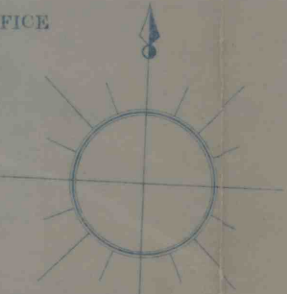

F 2466
-14-2000
C.C.