


MAP OF
ANSONVILLE FIELD


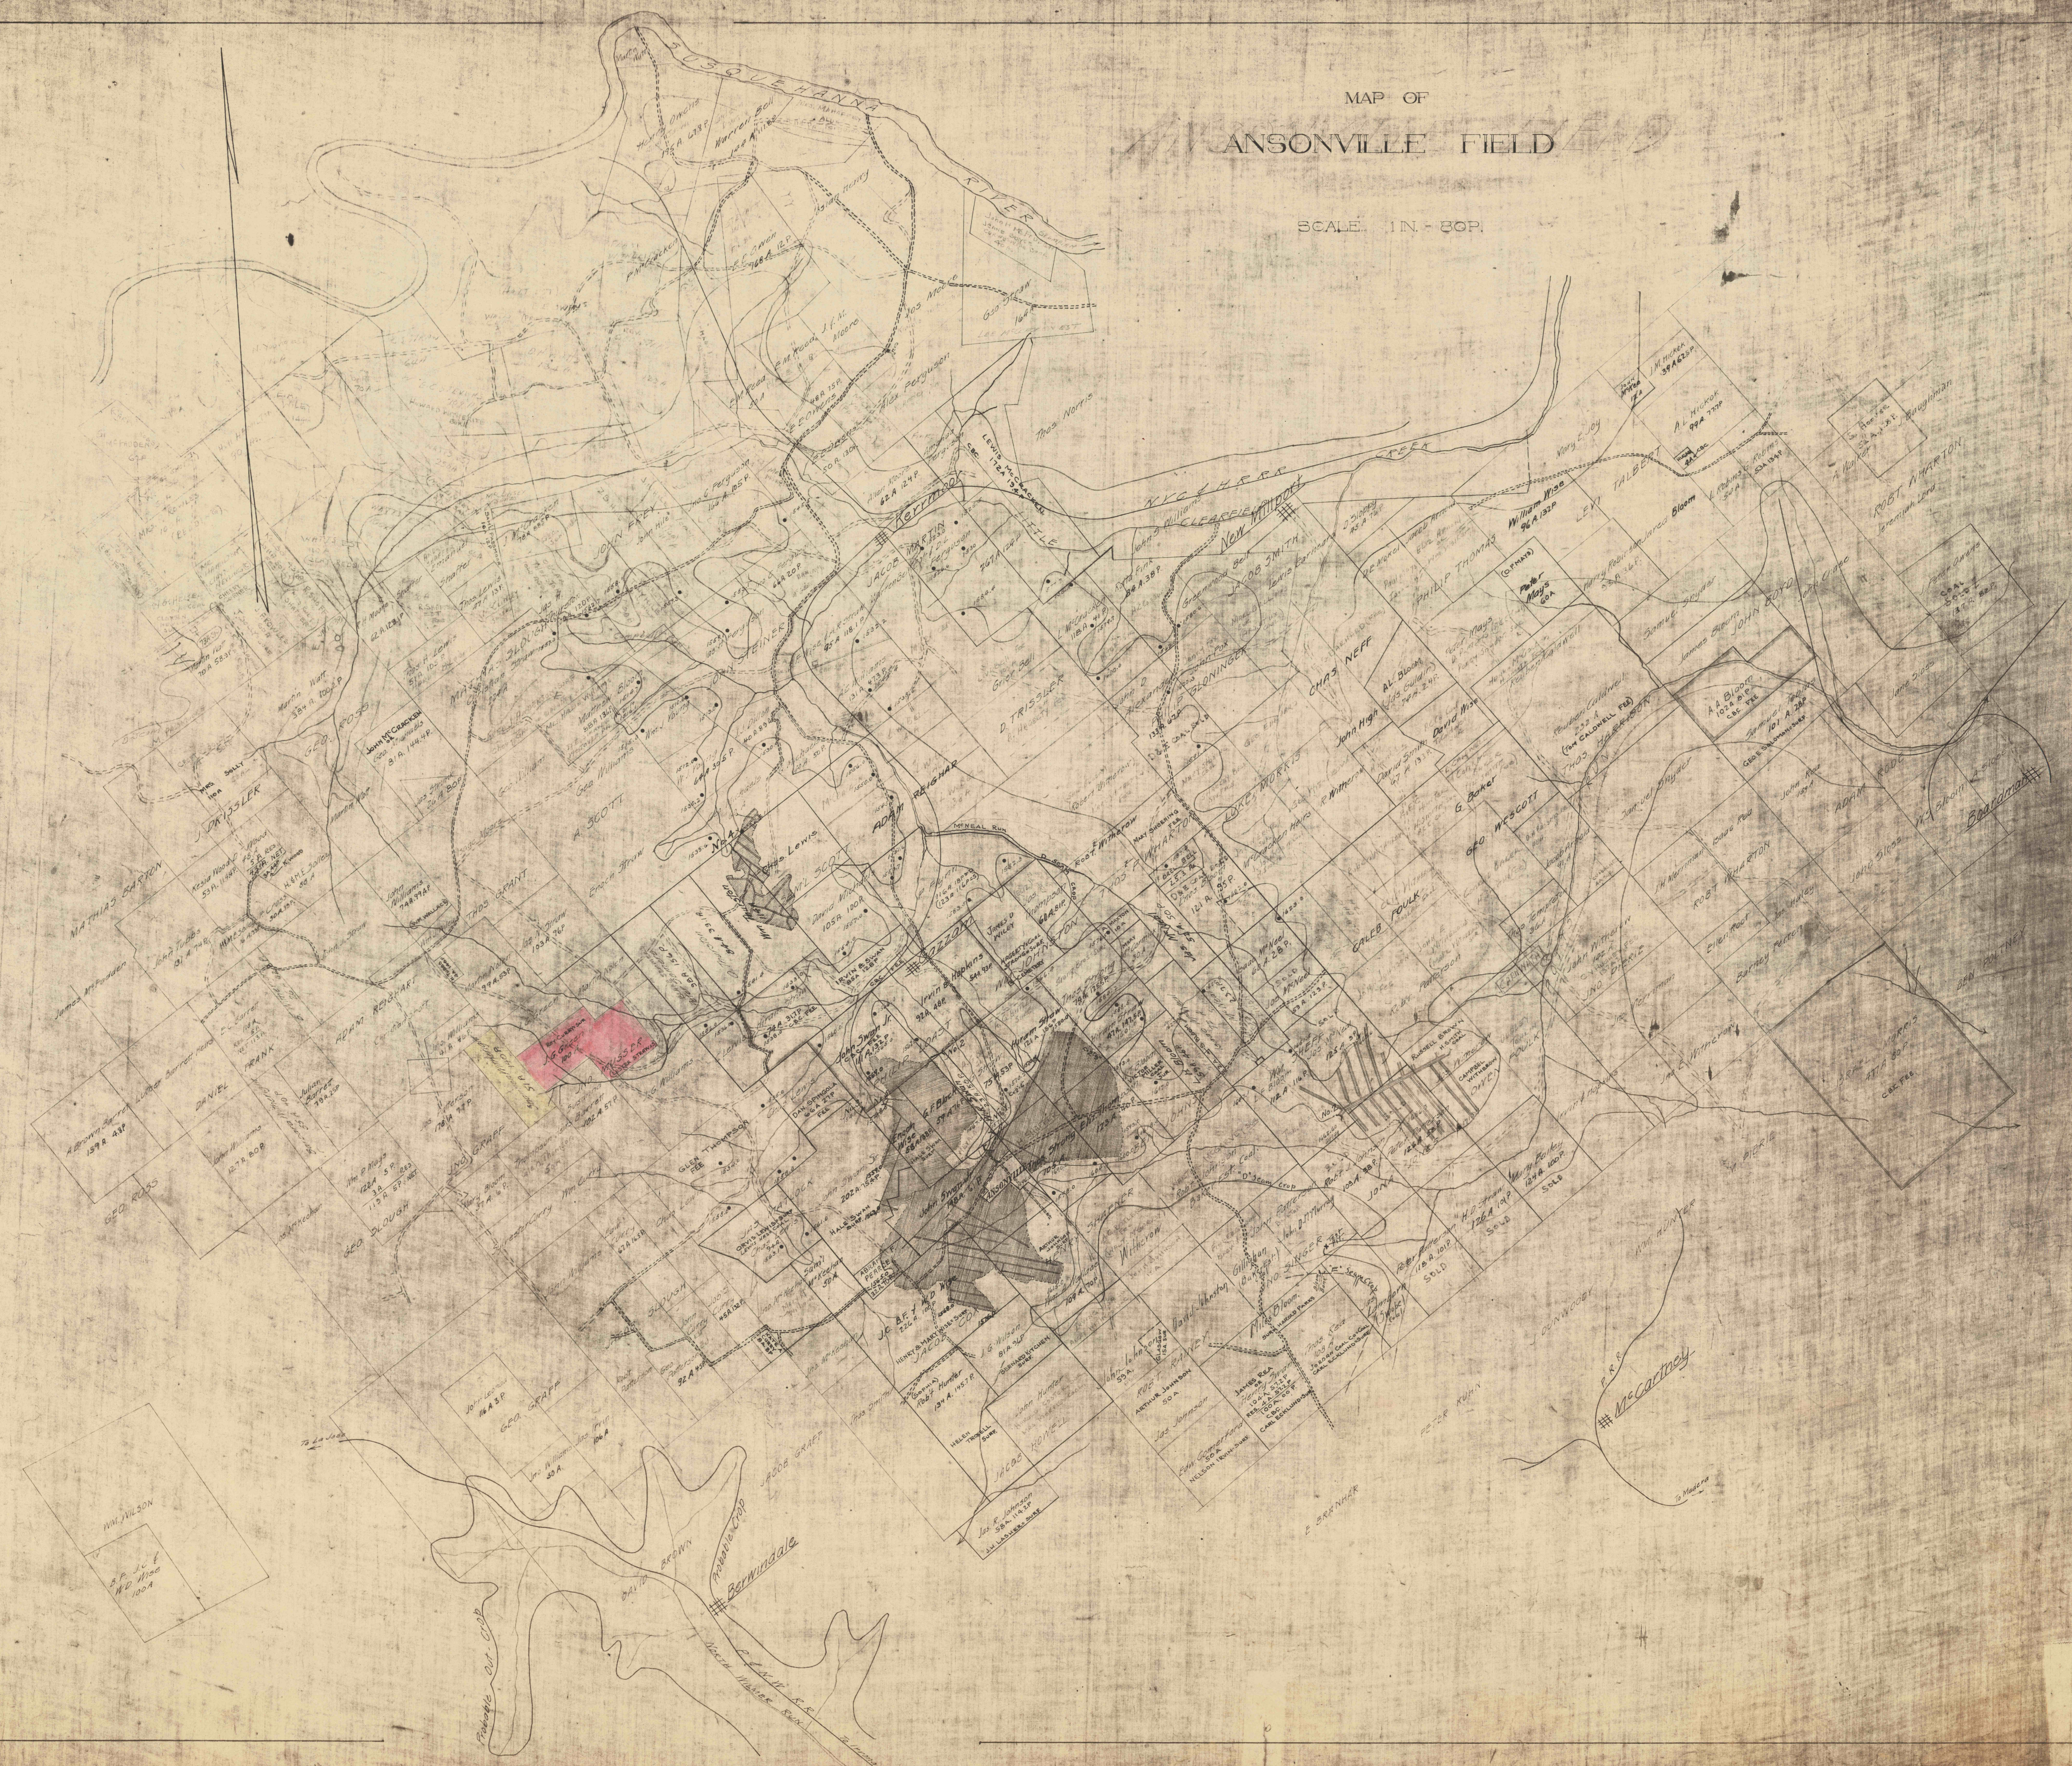

