

Clearfield

County


Susquehanna

Township

HOPKINS + IRVIN

Township

Indiana County

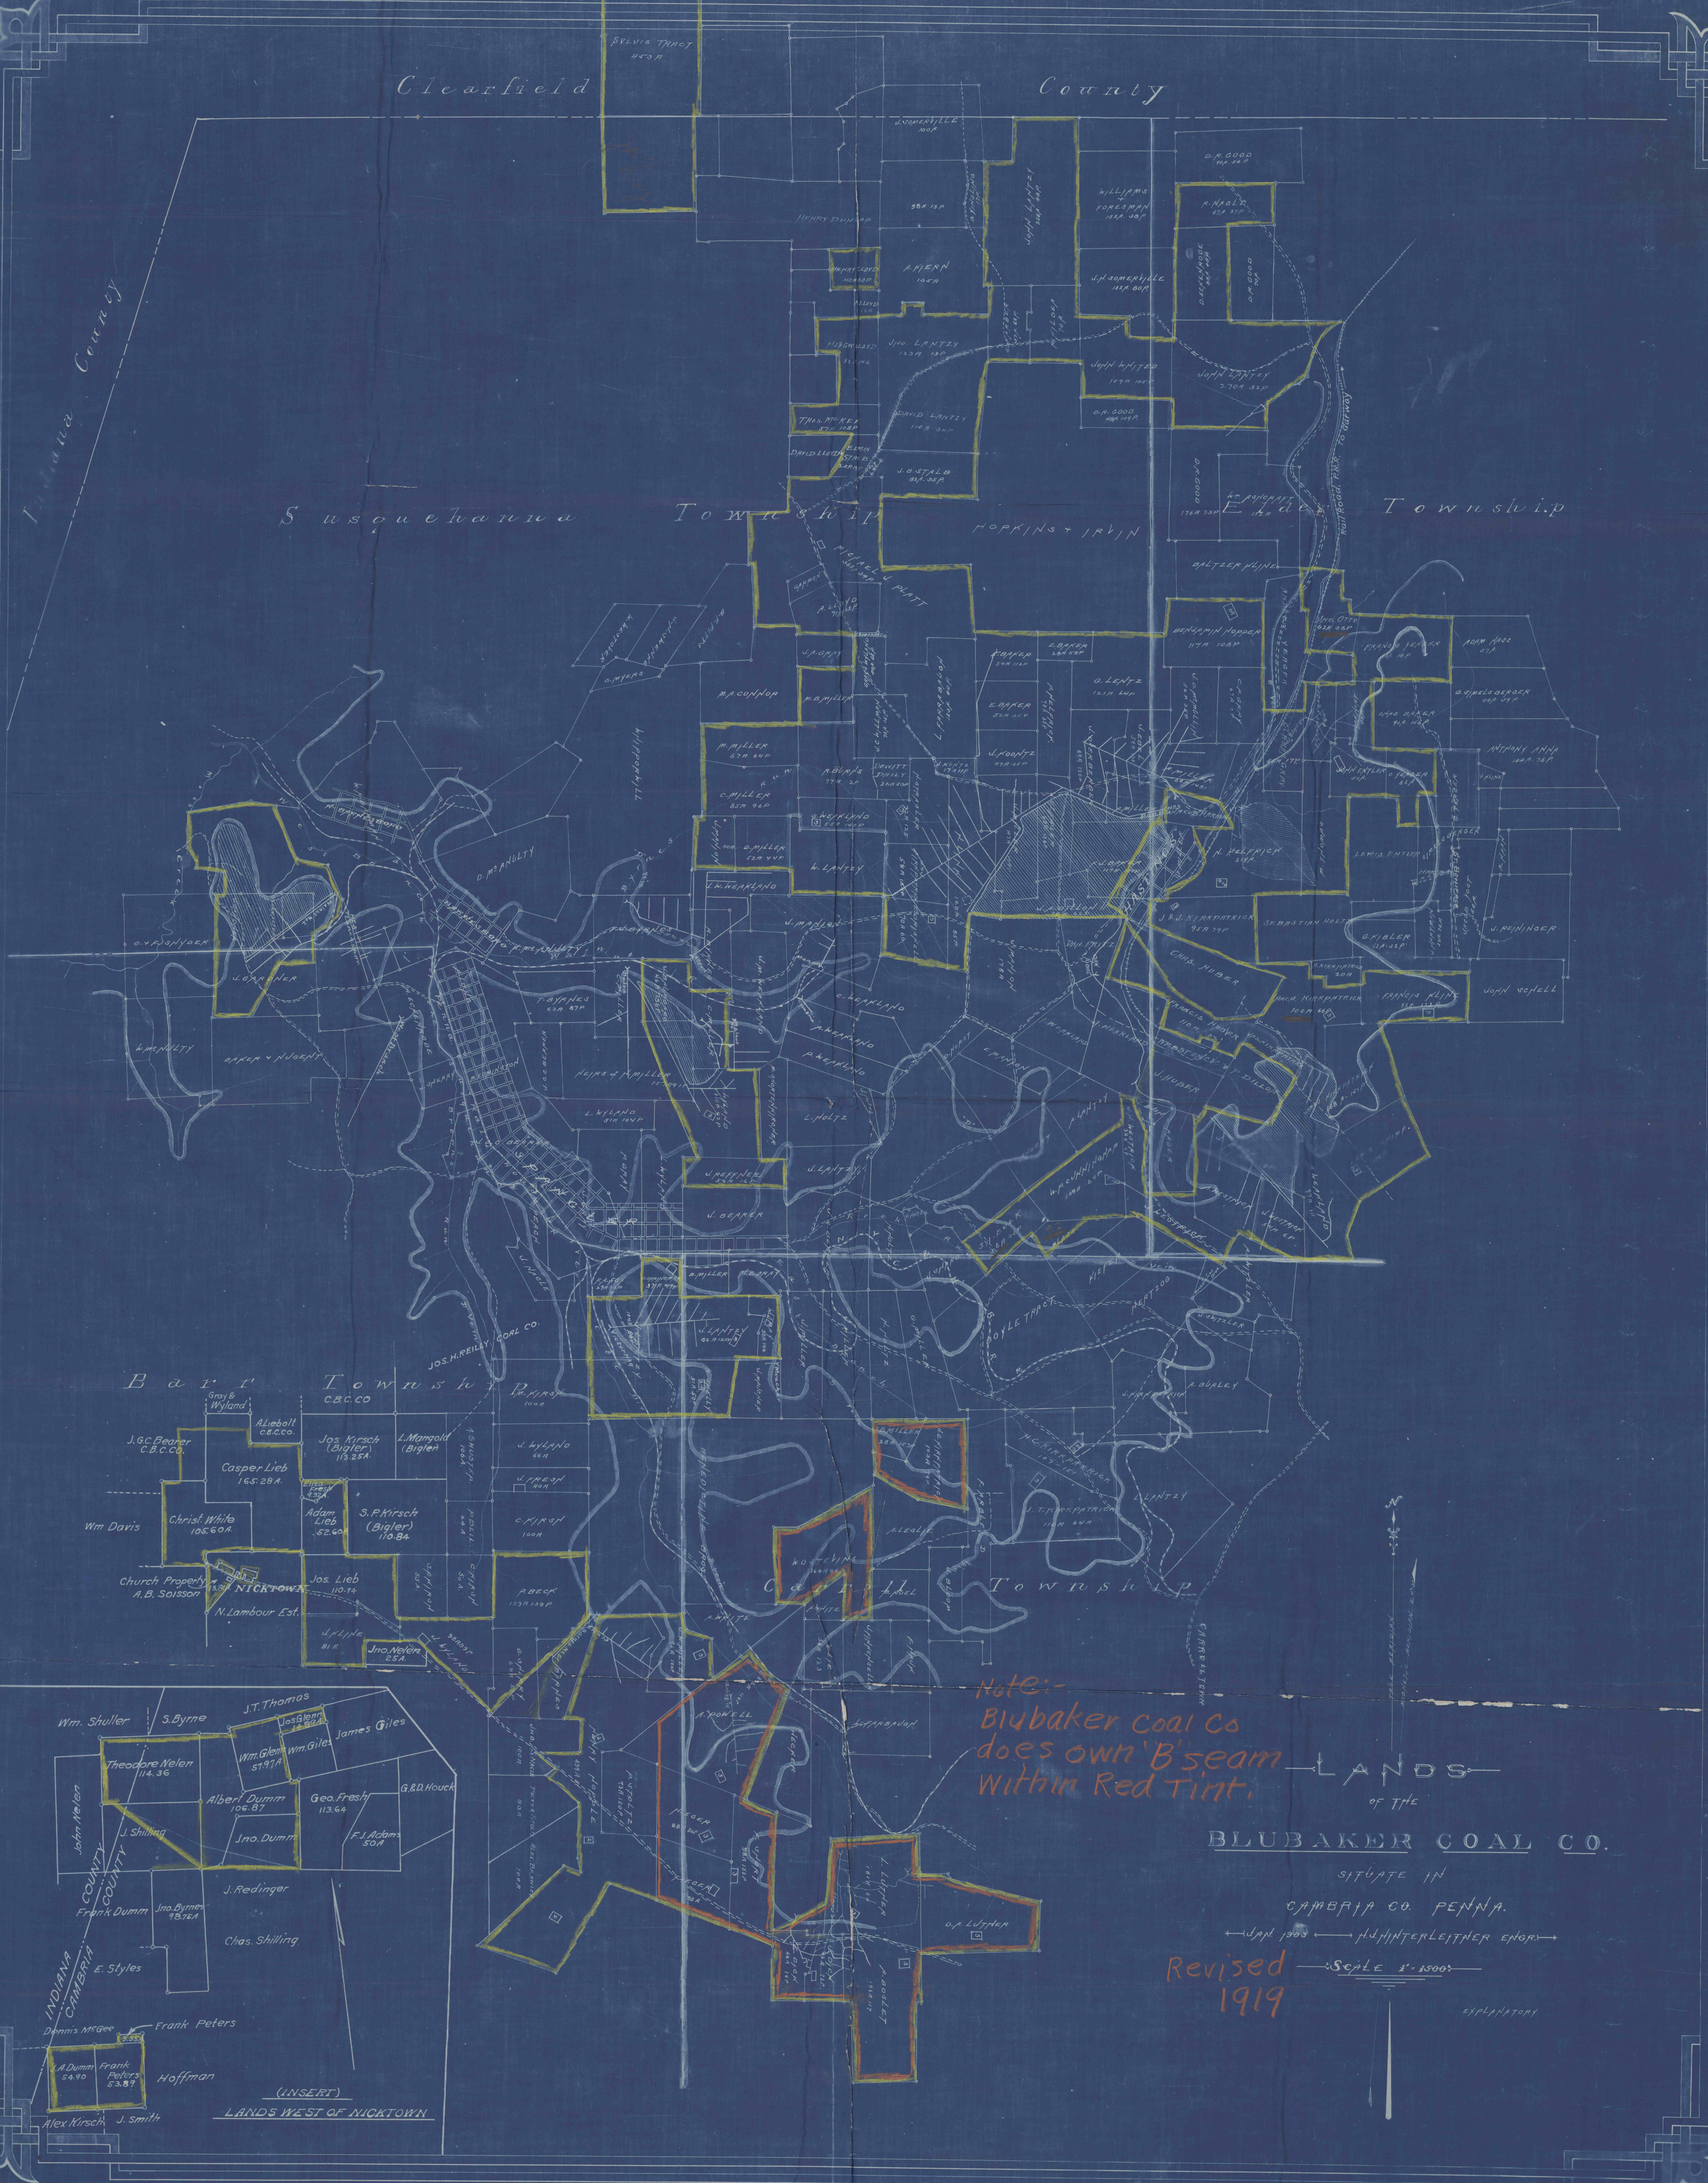

Note:
Blubaker coal Co
does own 'B' seam
within Red Tint.

LANDS
OF THE
BLUBAKER COAL CO.


SITUATE IN
CAMBRIA CO. PENNA.

April 1900 H. HINTERLEITNER ENGINEER

Revised
1919

SCALE 1" = 1500'

EXPLANATORY

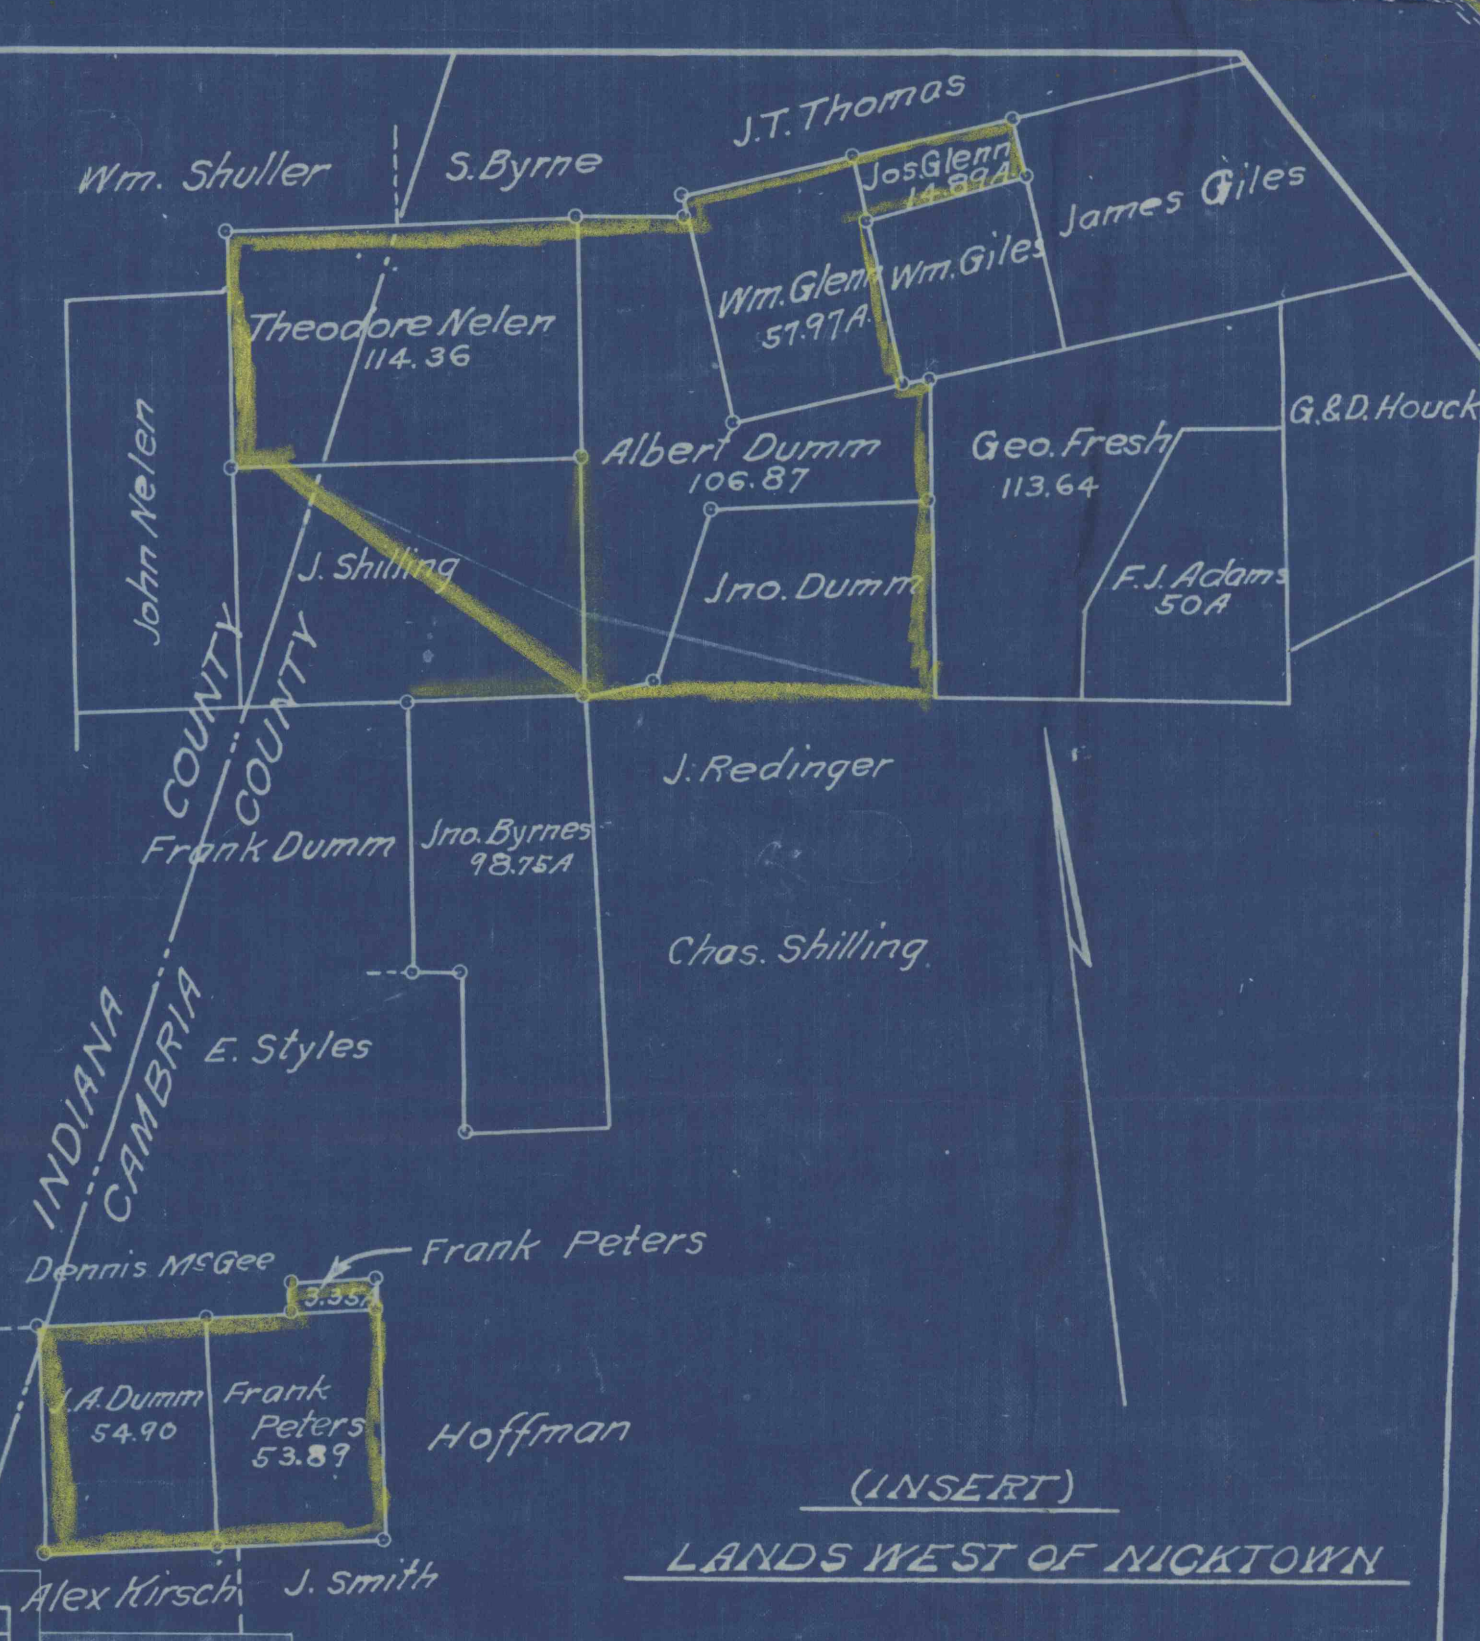

(INSERT)
LANDS WEST OF NICKTOWN