


Clearfield County

STATUS OF MINES NOV. 9, 1922

OPERATING CO.	NAME OF MINE	KIND OF OPENING	COAL SHOWN	KIND OF MINED	STATUS
Navy Smokeless C. Co.	Navy Smokeless	Drift	B	Open	Closed
Sterling C. Co.	#186	Drift	B	Open	Open
Barnes C. Co.	#14	Slope	B	Open	Open
Ward C. Co.	#3	Drift	B	Open	Closed
Watkins C. Co.	Victor #12	Slope	B	Open	Open
U.S. H. Reilly C. Co.	Reilly #1	Shaft	B	Open	Open
Carrolltown C. Co.	Victor #3	Slope	B	Open	Open
Do.	Victor #10	Drift	B	Open	Open
F. B. C. Corp.	West Branch	Drift	B	Open	Open
Madsen-Hill C. M. Co.	Spangler #4	Shaft	B	Open	Open
Cyn. B. H. C. Co.	Cymbria #2	Shaft	B	Open	Open
Duncan Spangler C.	Delta #2	Drift	D	Open	Open
Barnes & Tucker	#12	Drift	E & D	Open	Open
Watkins C. Co.	#182	Drift	E & D	Open	Open

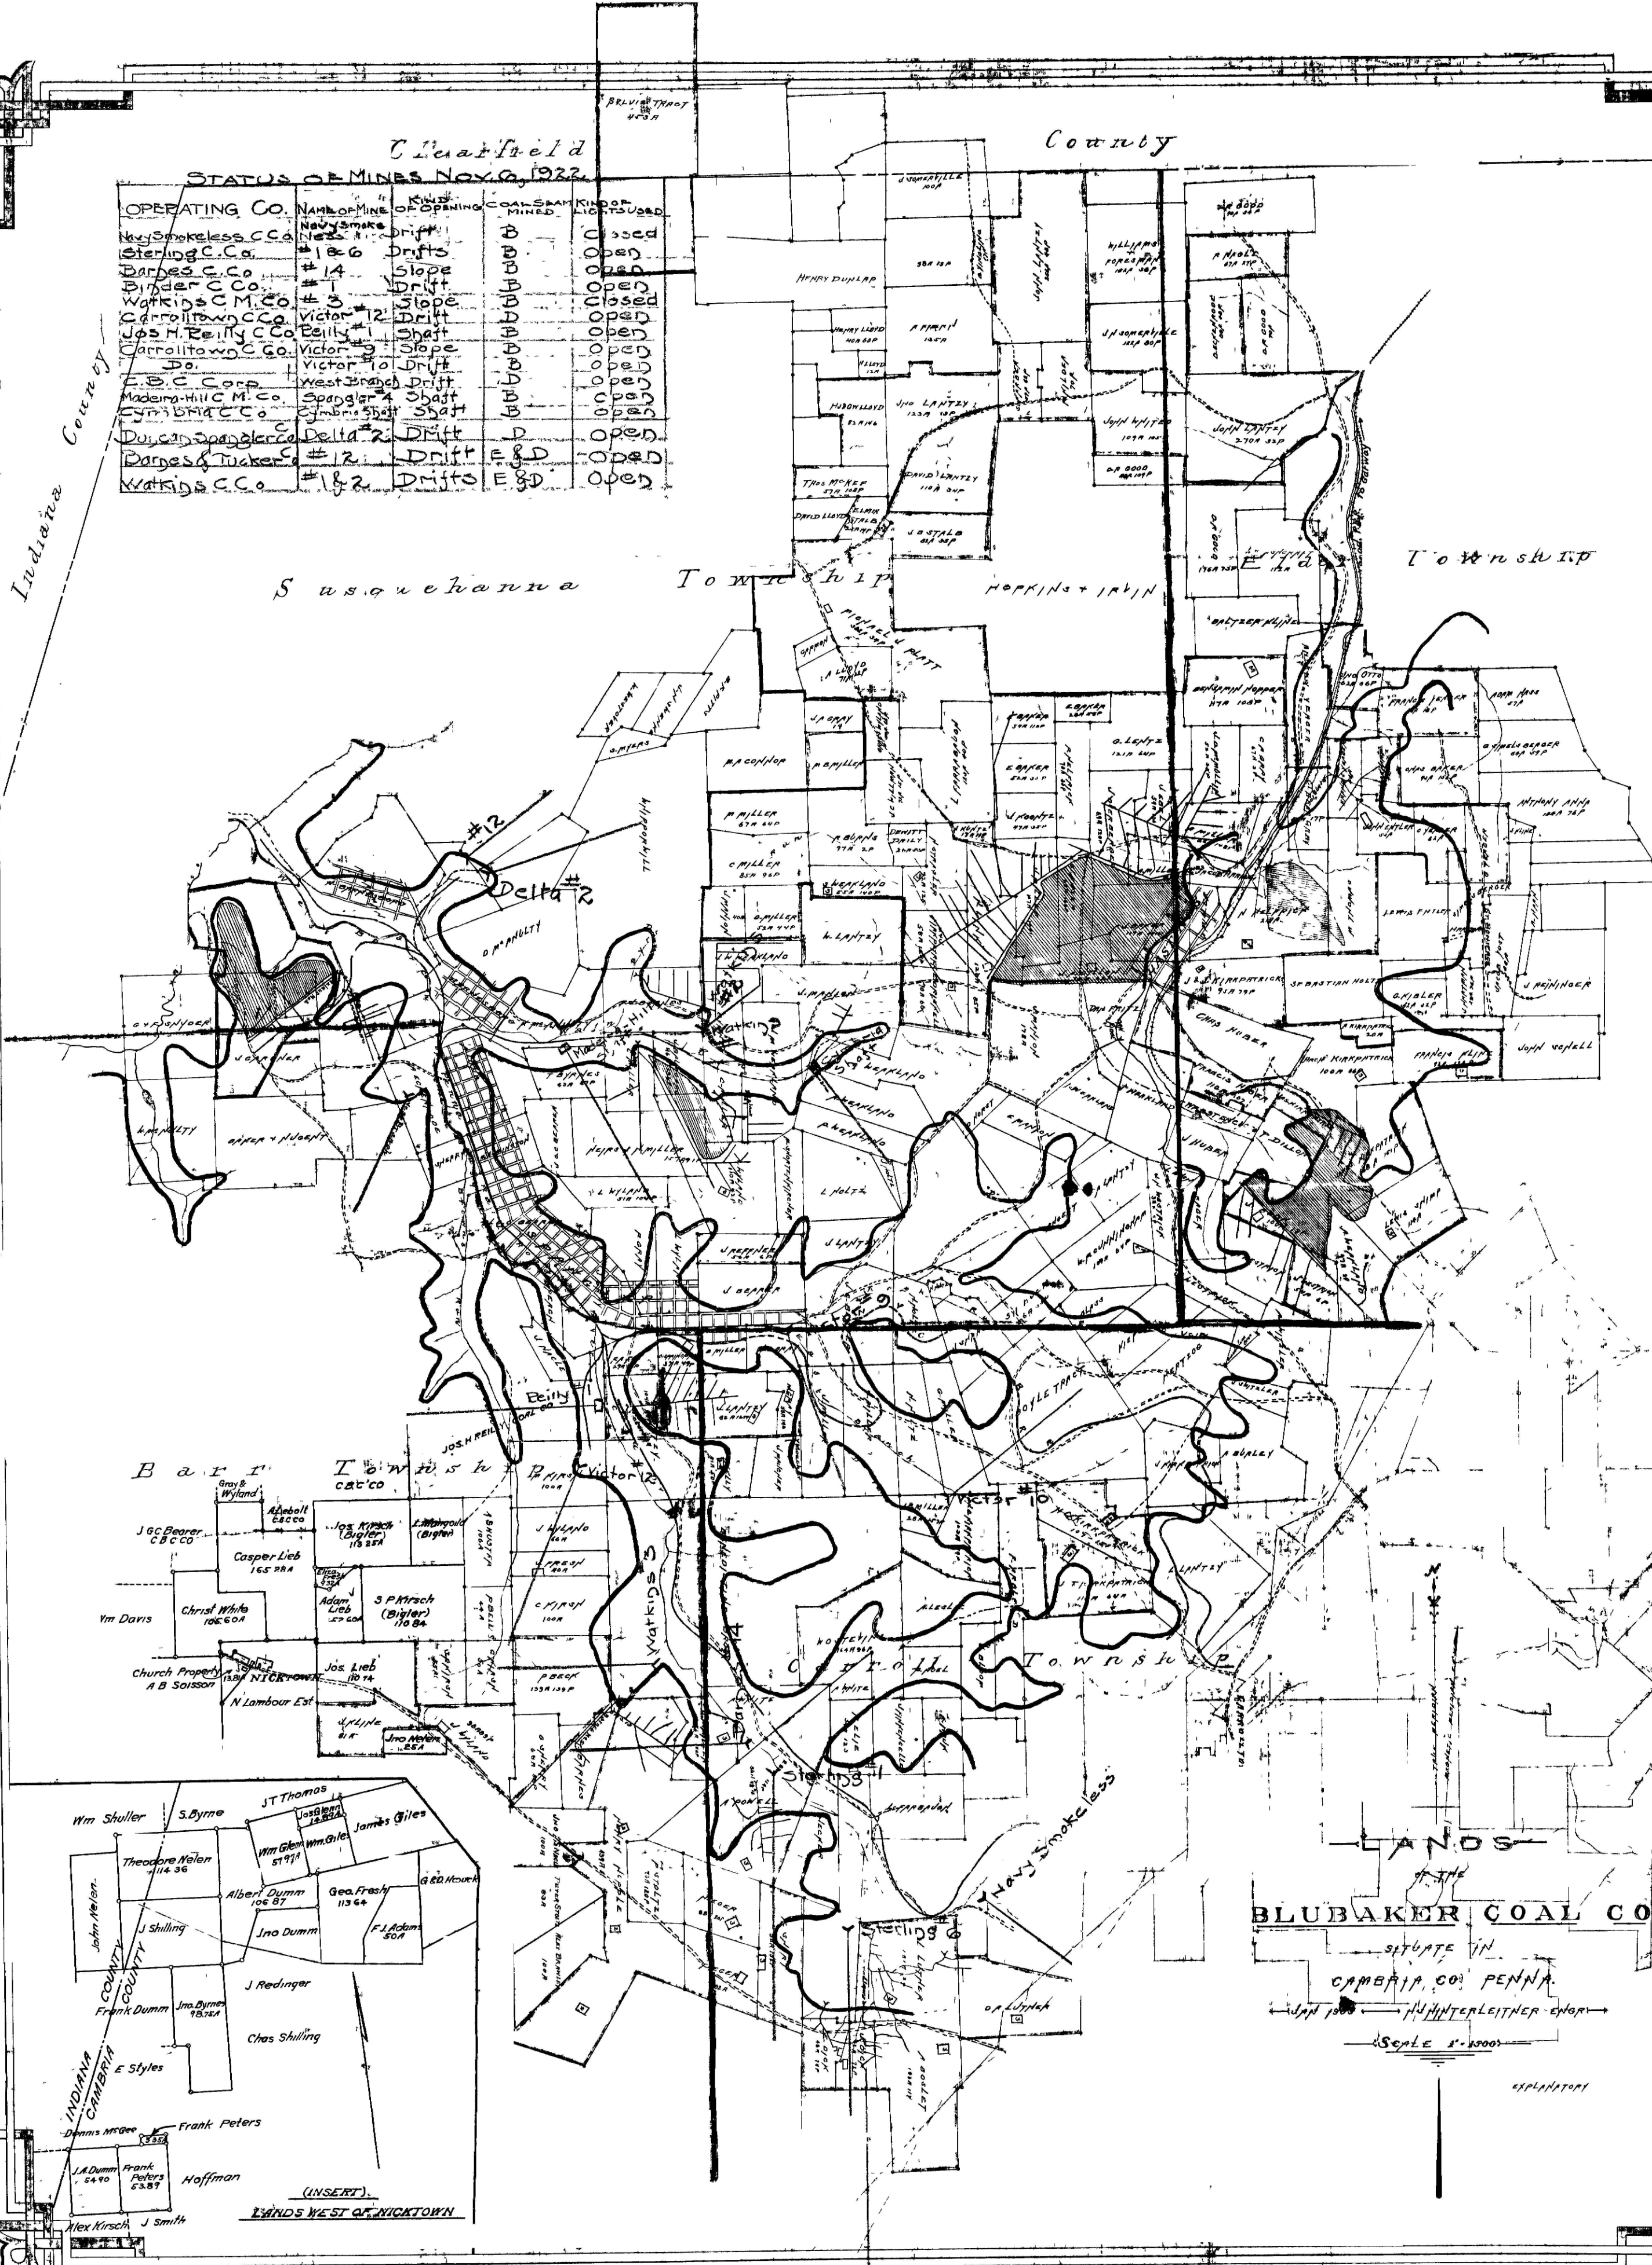

BLUBAKER COAL CO.

SITUATE IN CAMBRIA CO. PENNA.

By HUNTER LEITCHER - ENGR.

SCALE 1" = 1 MILE

EXPLANATORY

(INSERT)

LANDS WEST OF NICKTOWN