


Curwensville
7 1/2 Quad
05

Bell Run No. 1

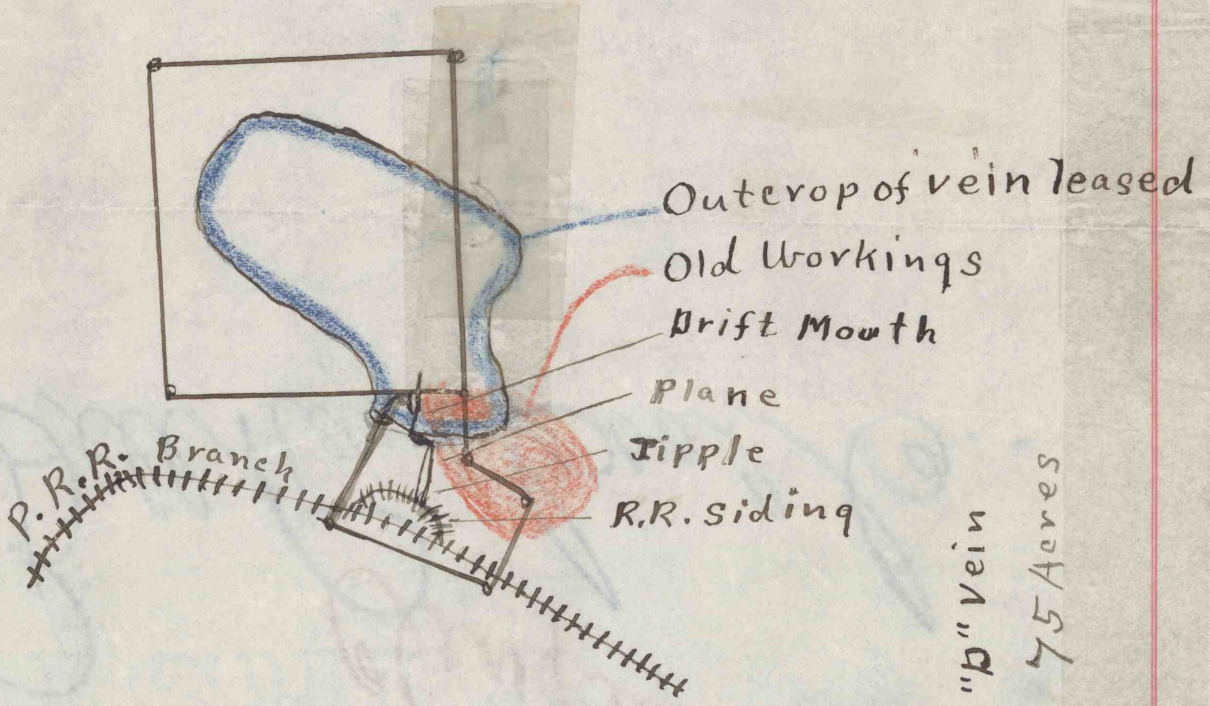

Scale 1" = 1650'

Bell Run Coal Co

Grampian Pa

Penn Township - Clearfield County

Leased from { E.A. Irvin Estate
C. Pardee et al

"b" vein
75 Acres
3' thick
Lower Freeport or
Acreege heased

75A @ 60% of 100

□ seam

#211
6-8-79
C.C.