


DEEP MINES
D 5550

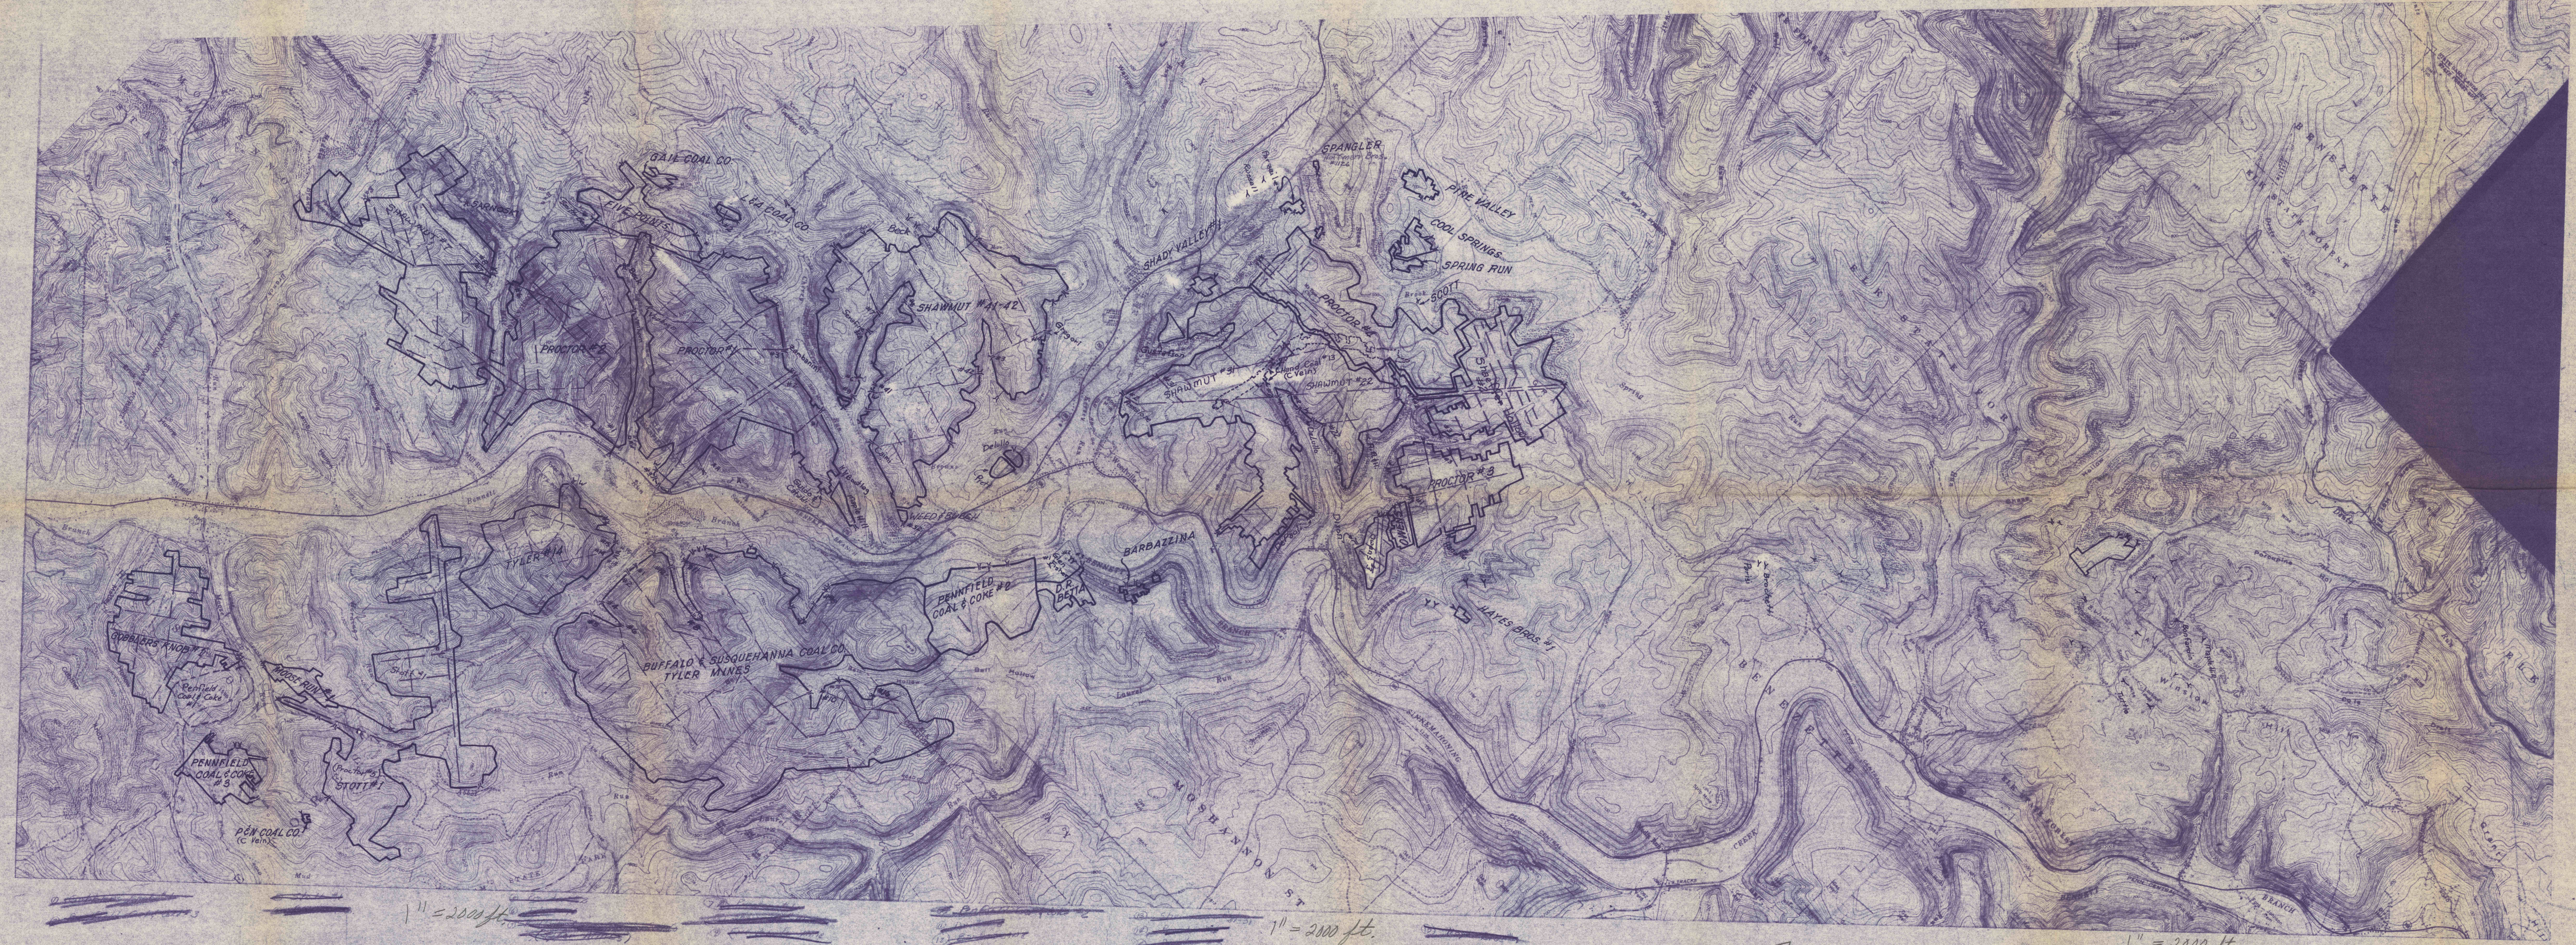

1" = 2000 ft. 1" = 2000 ft. 1" = 2000 ft.

367 Ac 201 Ac 92 Ac 1000 500 1.4 CAAL 250 125

Clearfield & Elk Counties
Various Deep Mine Locations

#557
6-25-97
C.C.

P.G.S.-325495

Deep Mines sheet - 145

1EA