


# Fairmont mine

EUGENE DIETZGEN CO.  
MADE IN U. S. A.

NO. 340  
DIETZGEN GRAPH PAPER  
10 X 10 PER INCH

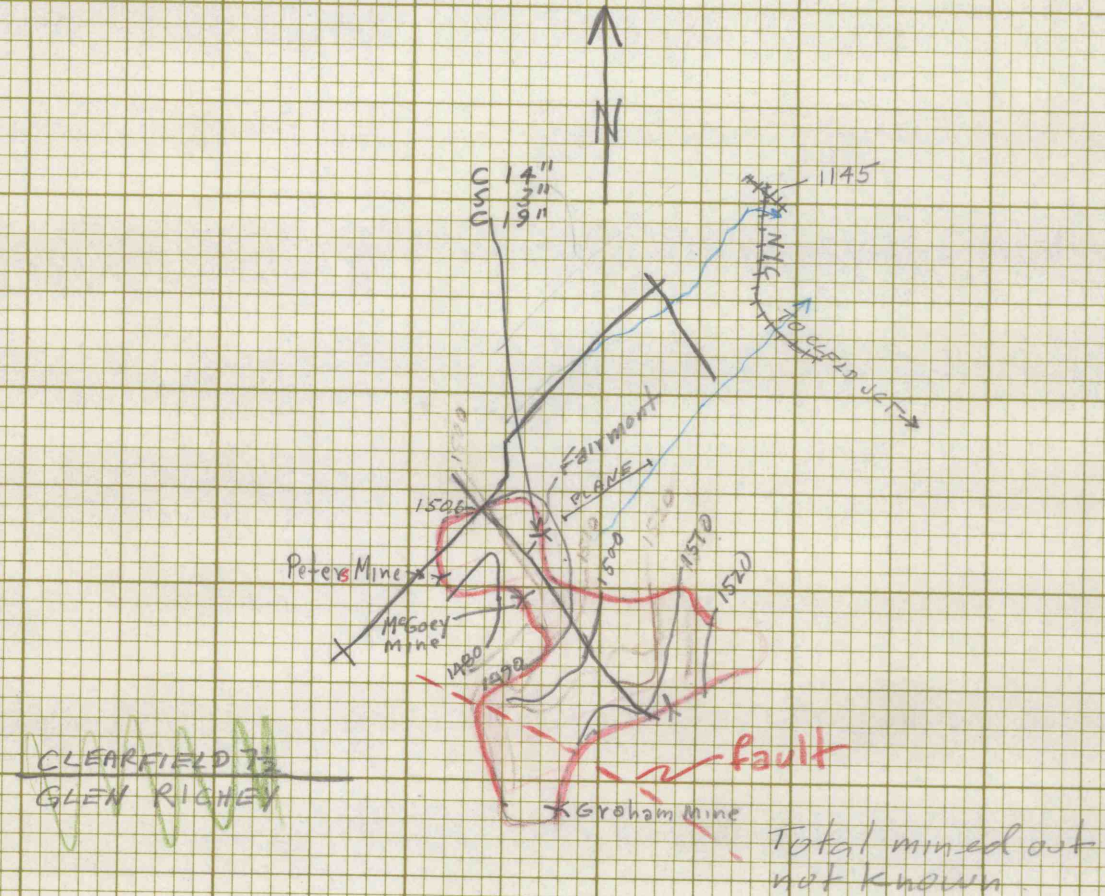

Fairmont mine  
Fyre Colleries  
E Coal  
Lawrence Twp  
Clearfield Co  
Clearfield Quad  
1:24,000

303420