


ROCHESTER MILLS, PA.  
N4045-W7852.5/7.5

BURNSIDE, PA.  
N4045-W7845/7.5

1968  
PHOTOREVISED 1981  
DMA 5285 IV SW SERIES Y831

1968  
PHOTOREVISED 1981  
DMA 5285 IV SE - SERIES Y831

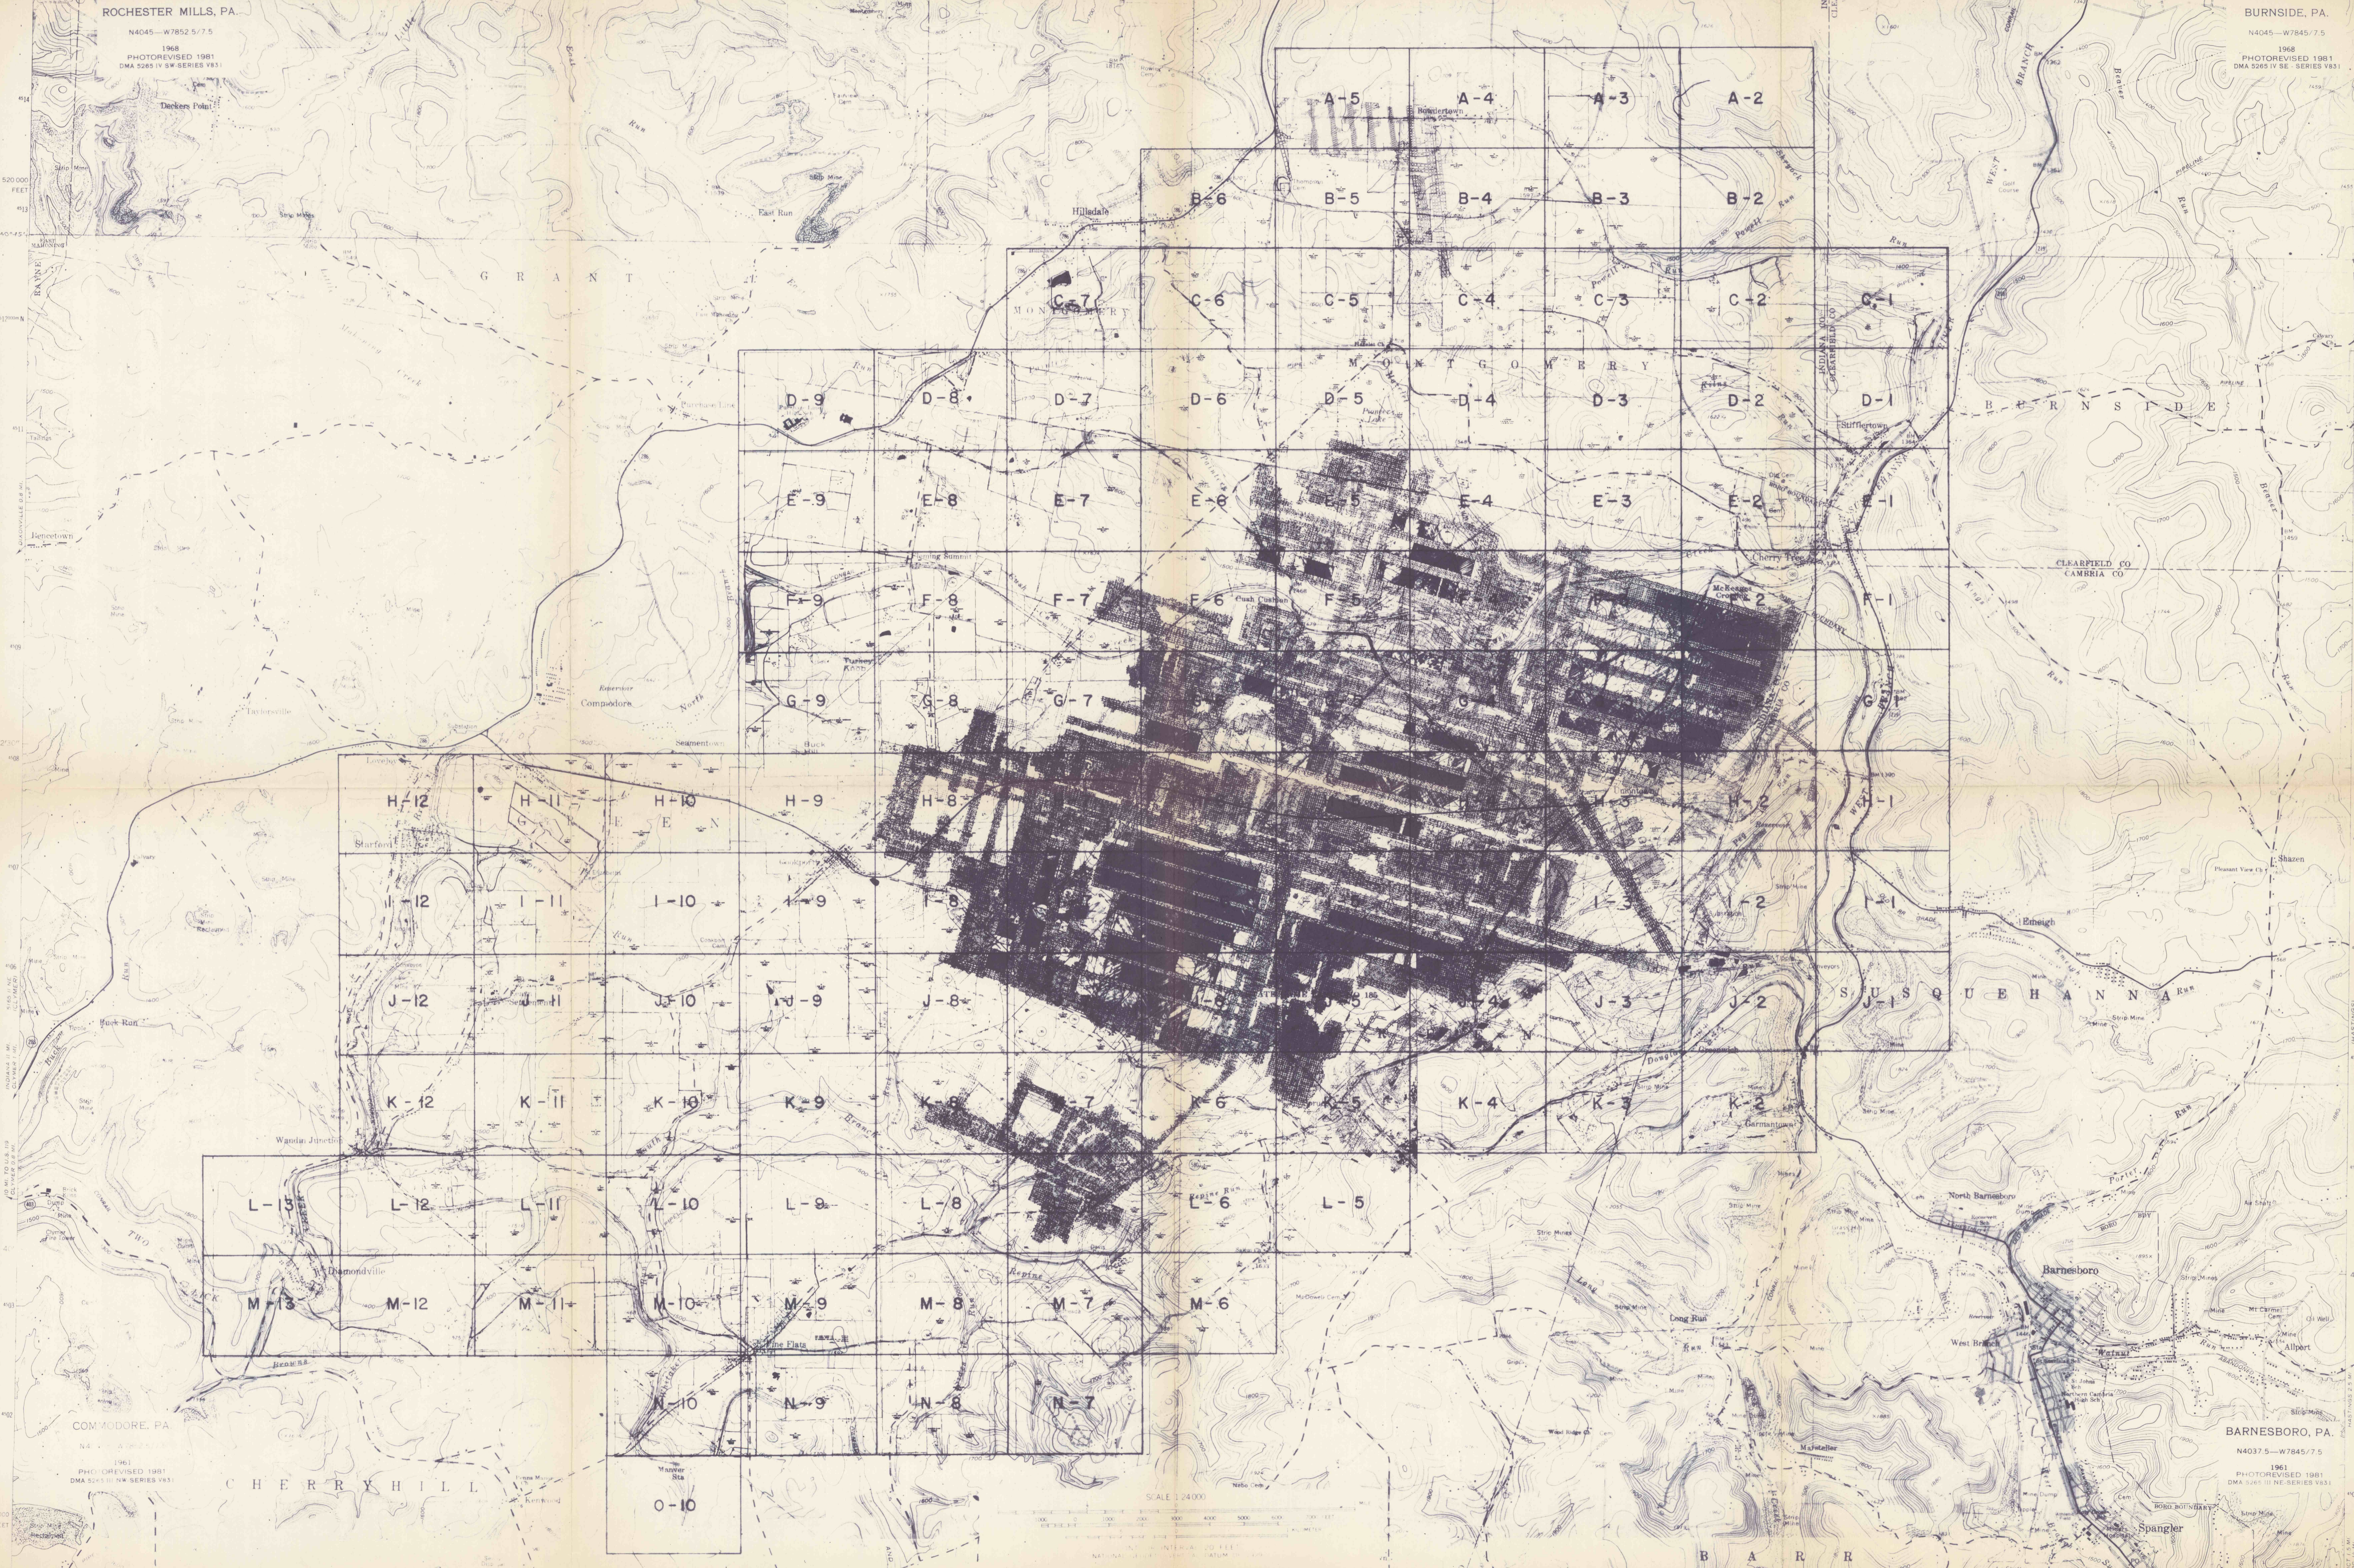

SCALE 1:24,000

1 2 3 4 5 6 7 8 9 10 11 12  
0 1000 2000 3000 4000 5000 6000 7000 8000 9000  
NAT. INT. 20 FEET  
NATIONAL SYSTEM OF MILES

CHERRYHILL

BARR

COMMODORE, PA.  
N4037.5-W7845/7.5

BARNESBORO, PA.  
N4037.5-W7845/7.5

1961  
PHOTOREVISED 1981  
DMA 5285 III SW SERIES Y831

1961  
PHOTOREVISED 1981  
DMA 5285 III SE SERIES Y831