


█ PARK
█ ARMSTRONG
█ MAHER

KELLY STATION FEE
 Worked out Area
 Crop
 Don't Own

L. W. Hicks Coal Company
 Kelly Station
 Bethel Twp. Armstrong County
 Scale 1" = 2000'

#1281
 8-3-99
 CC

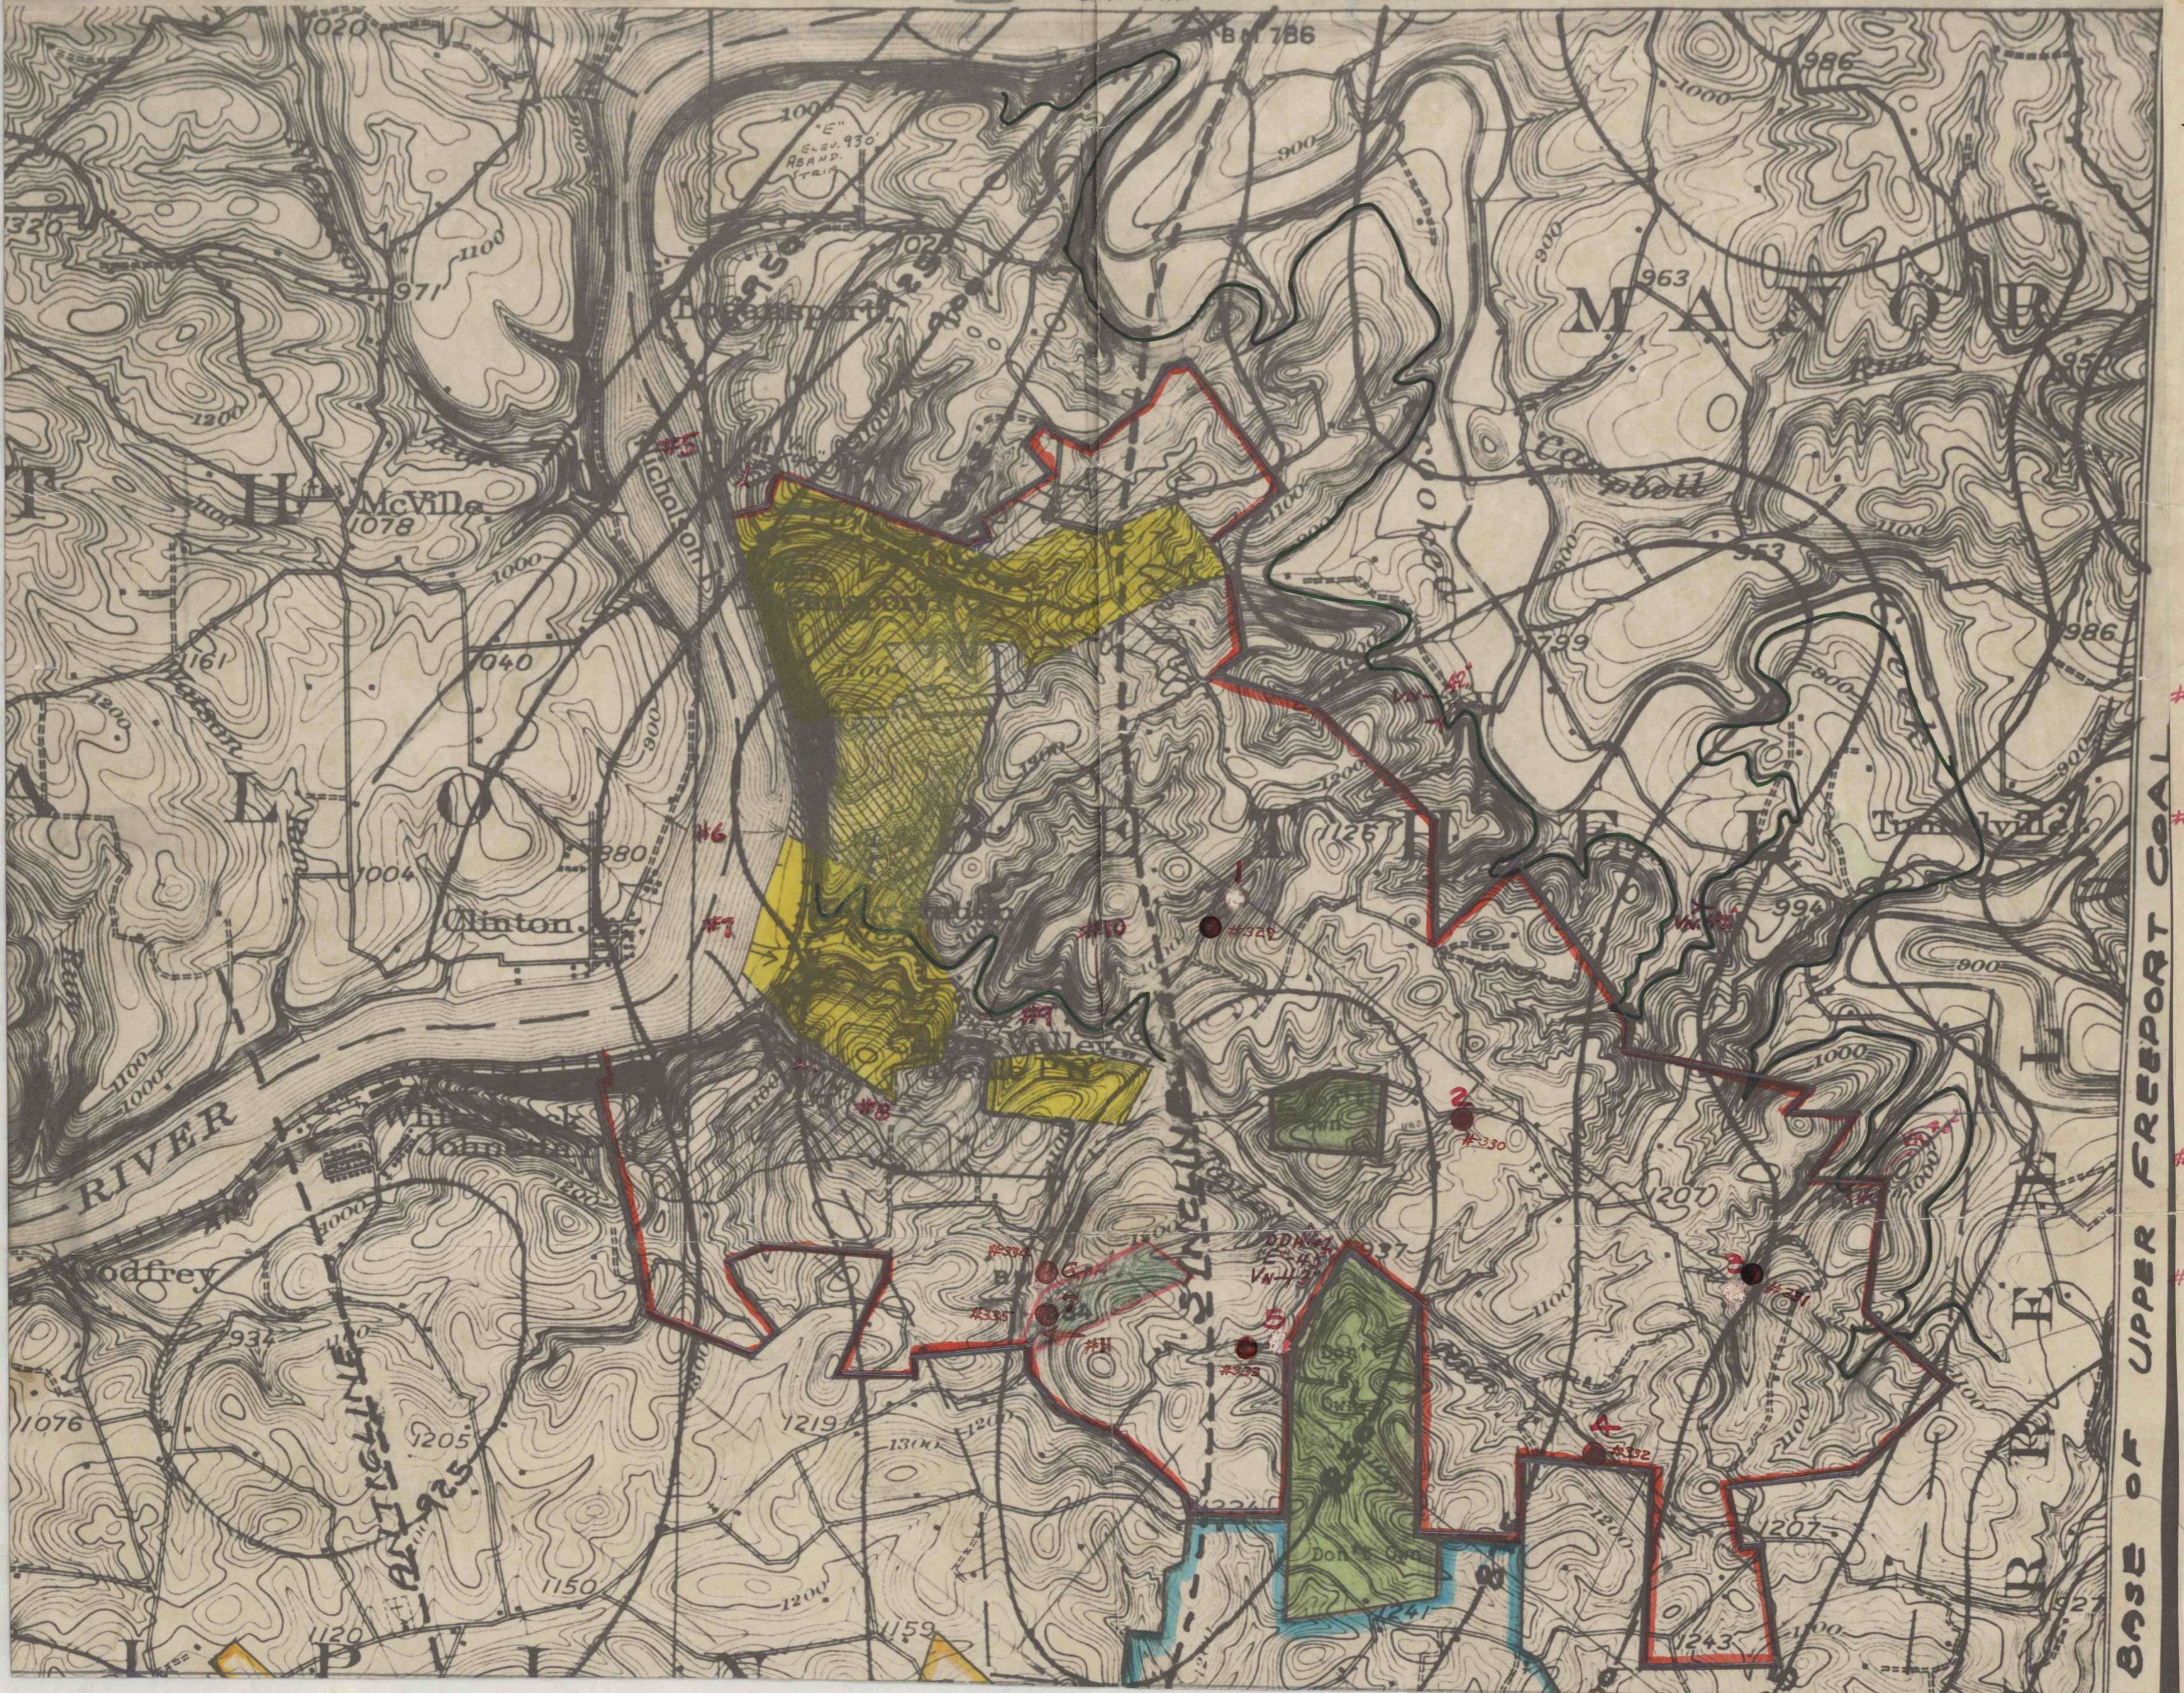

BASE OF UPPER FREEPORT COAL