


PRINT-2A

DDM #30  
CAL. 10"  
CRA. 24"

DDM #30  
CAL. 10"  
CRA. 24"

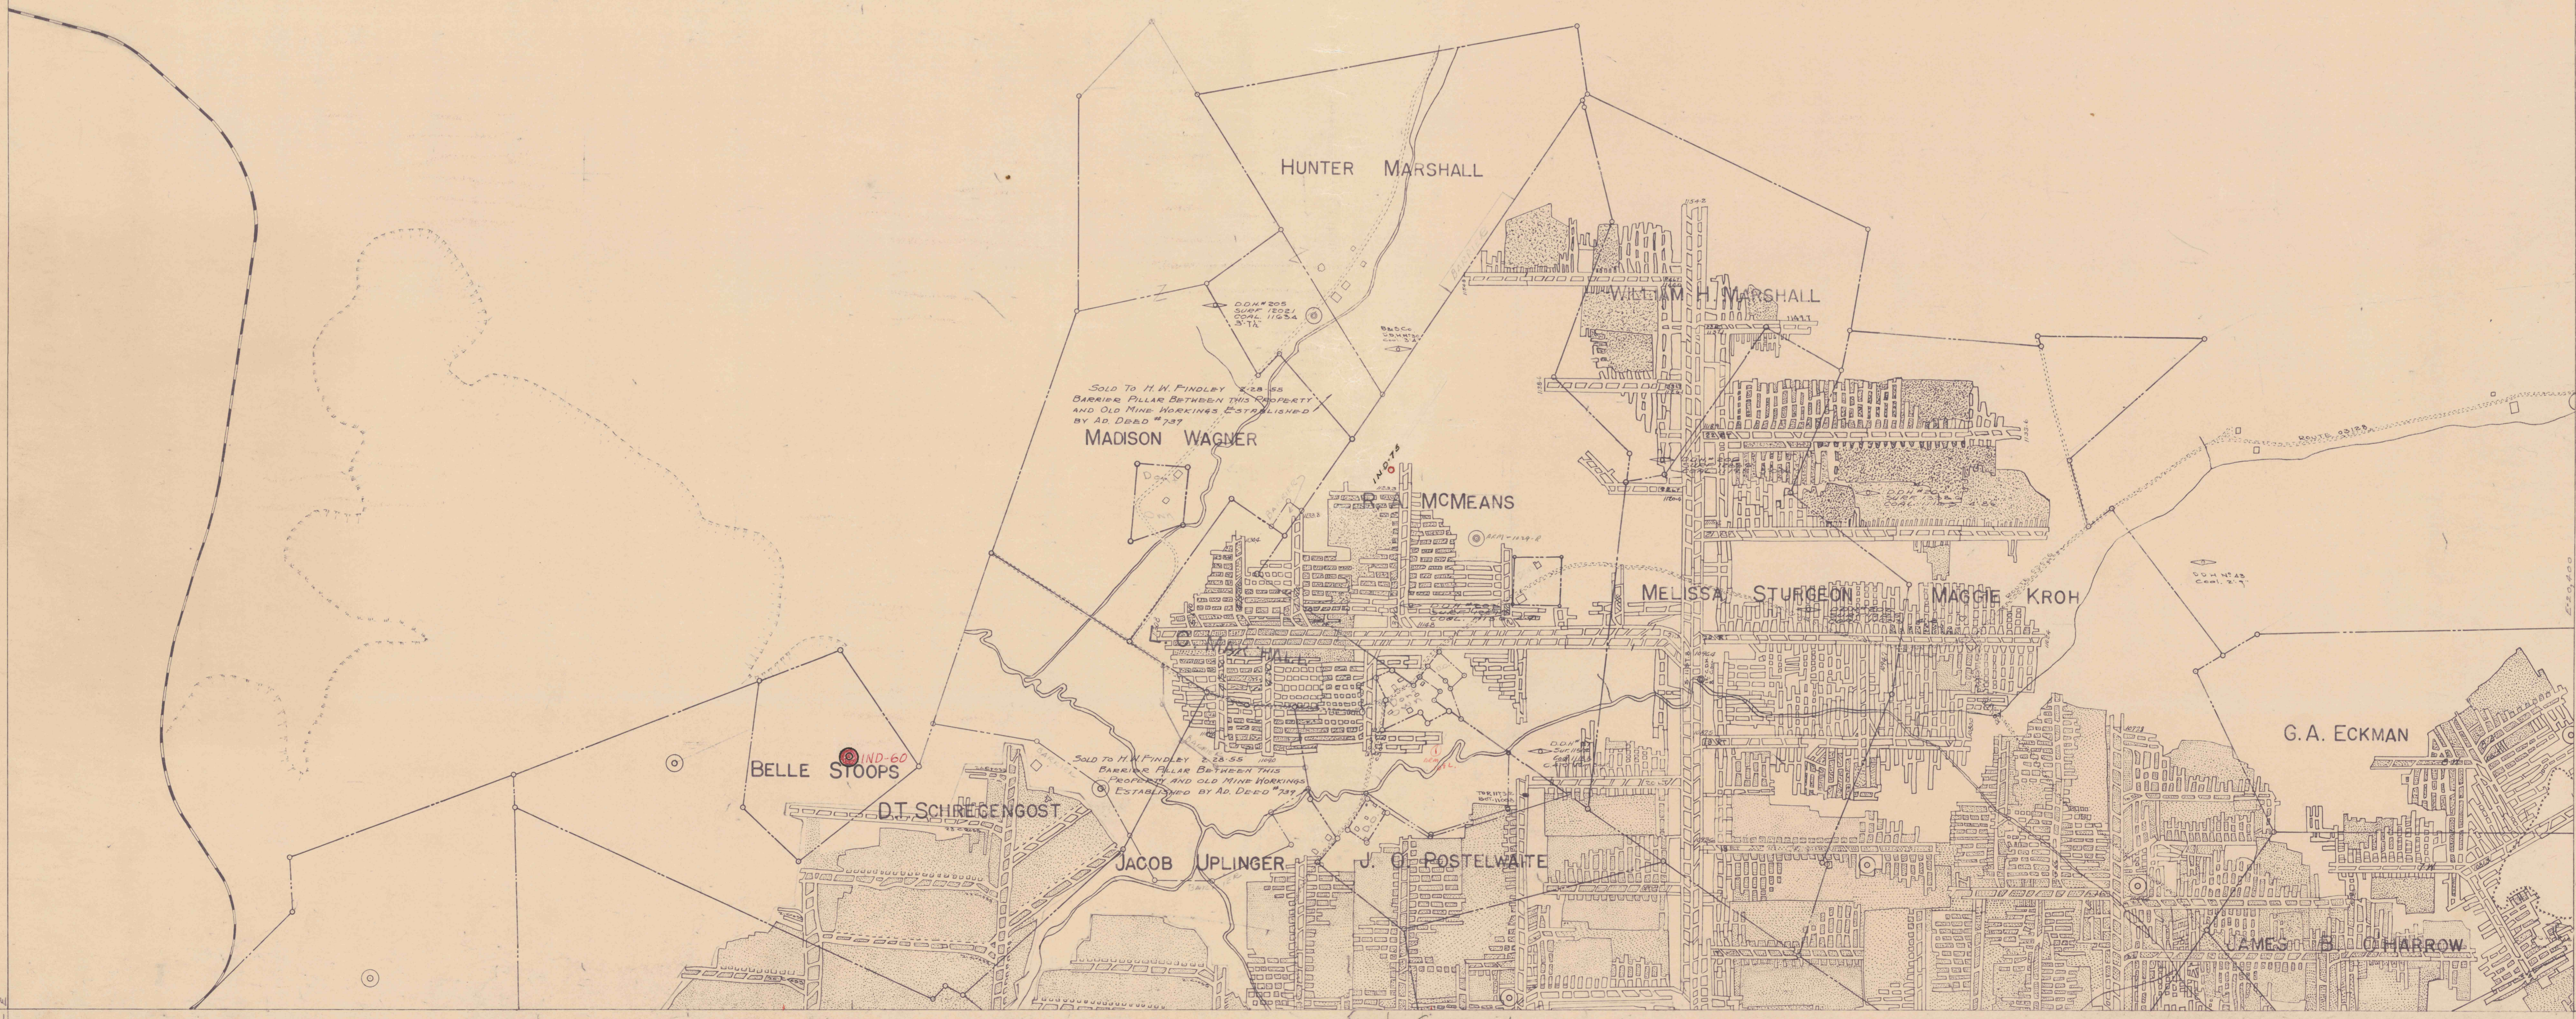

Sheet 1