


MINE 33 B 1"=200' KEYSHEET

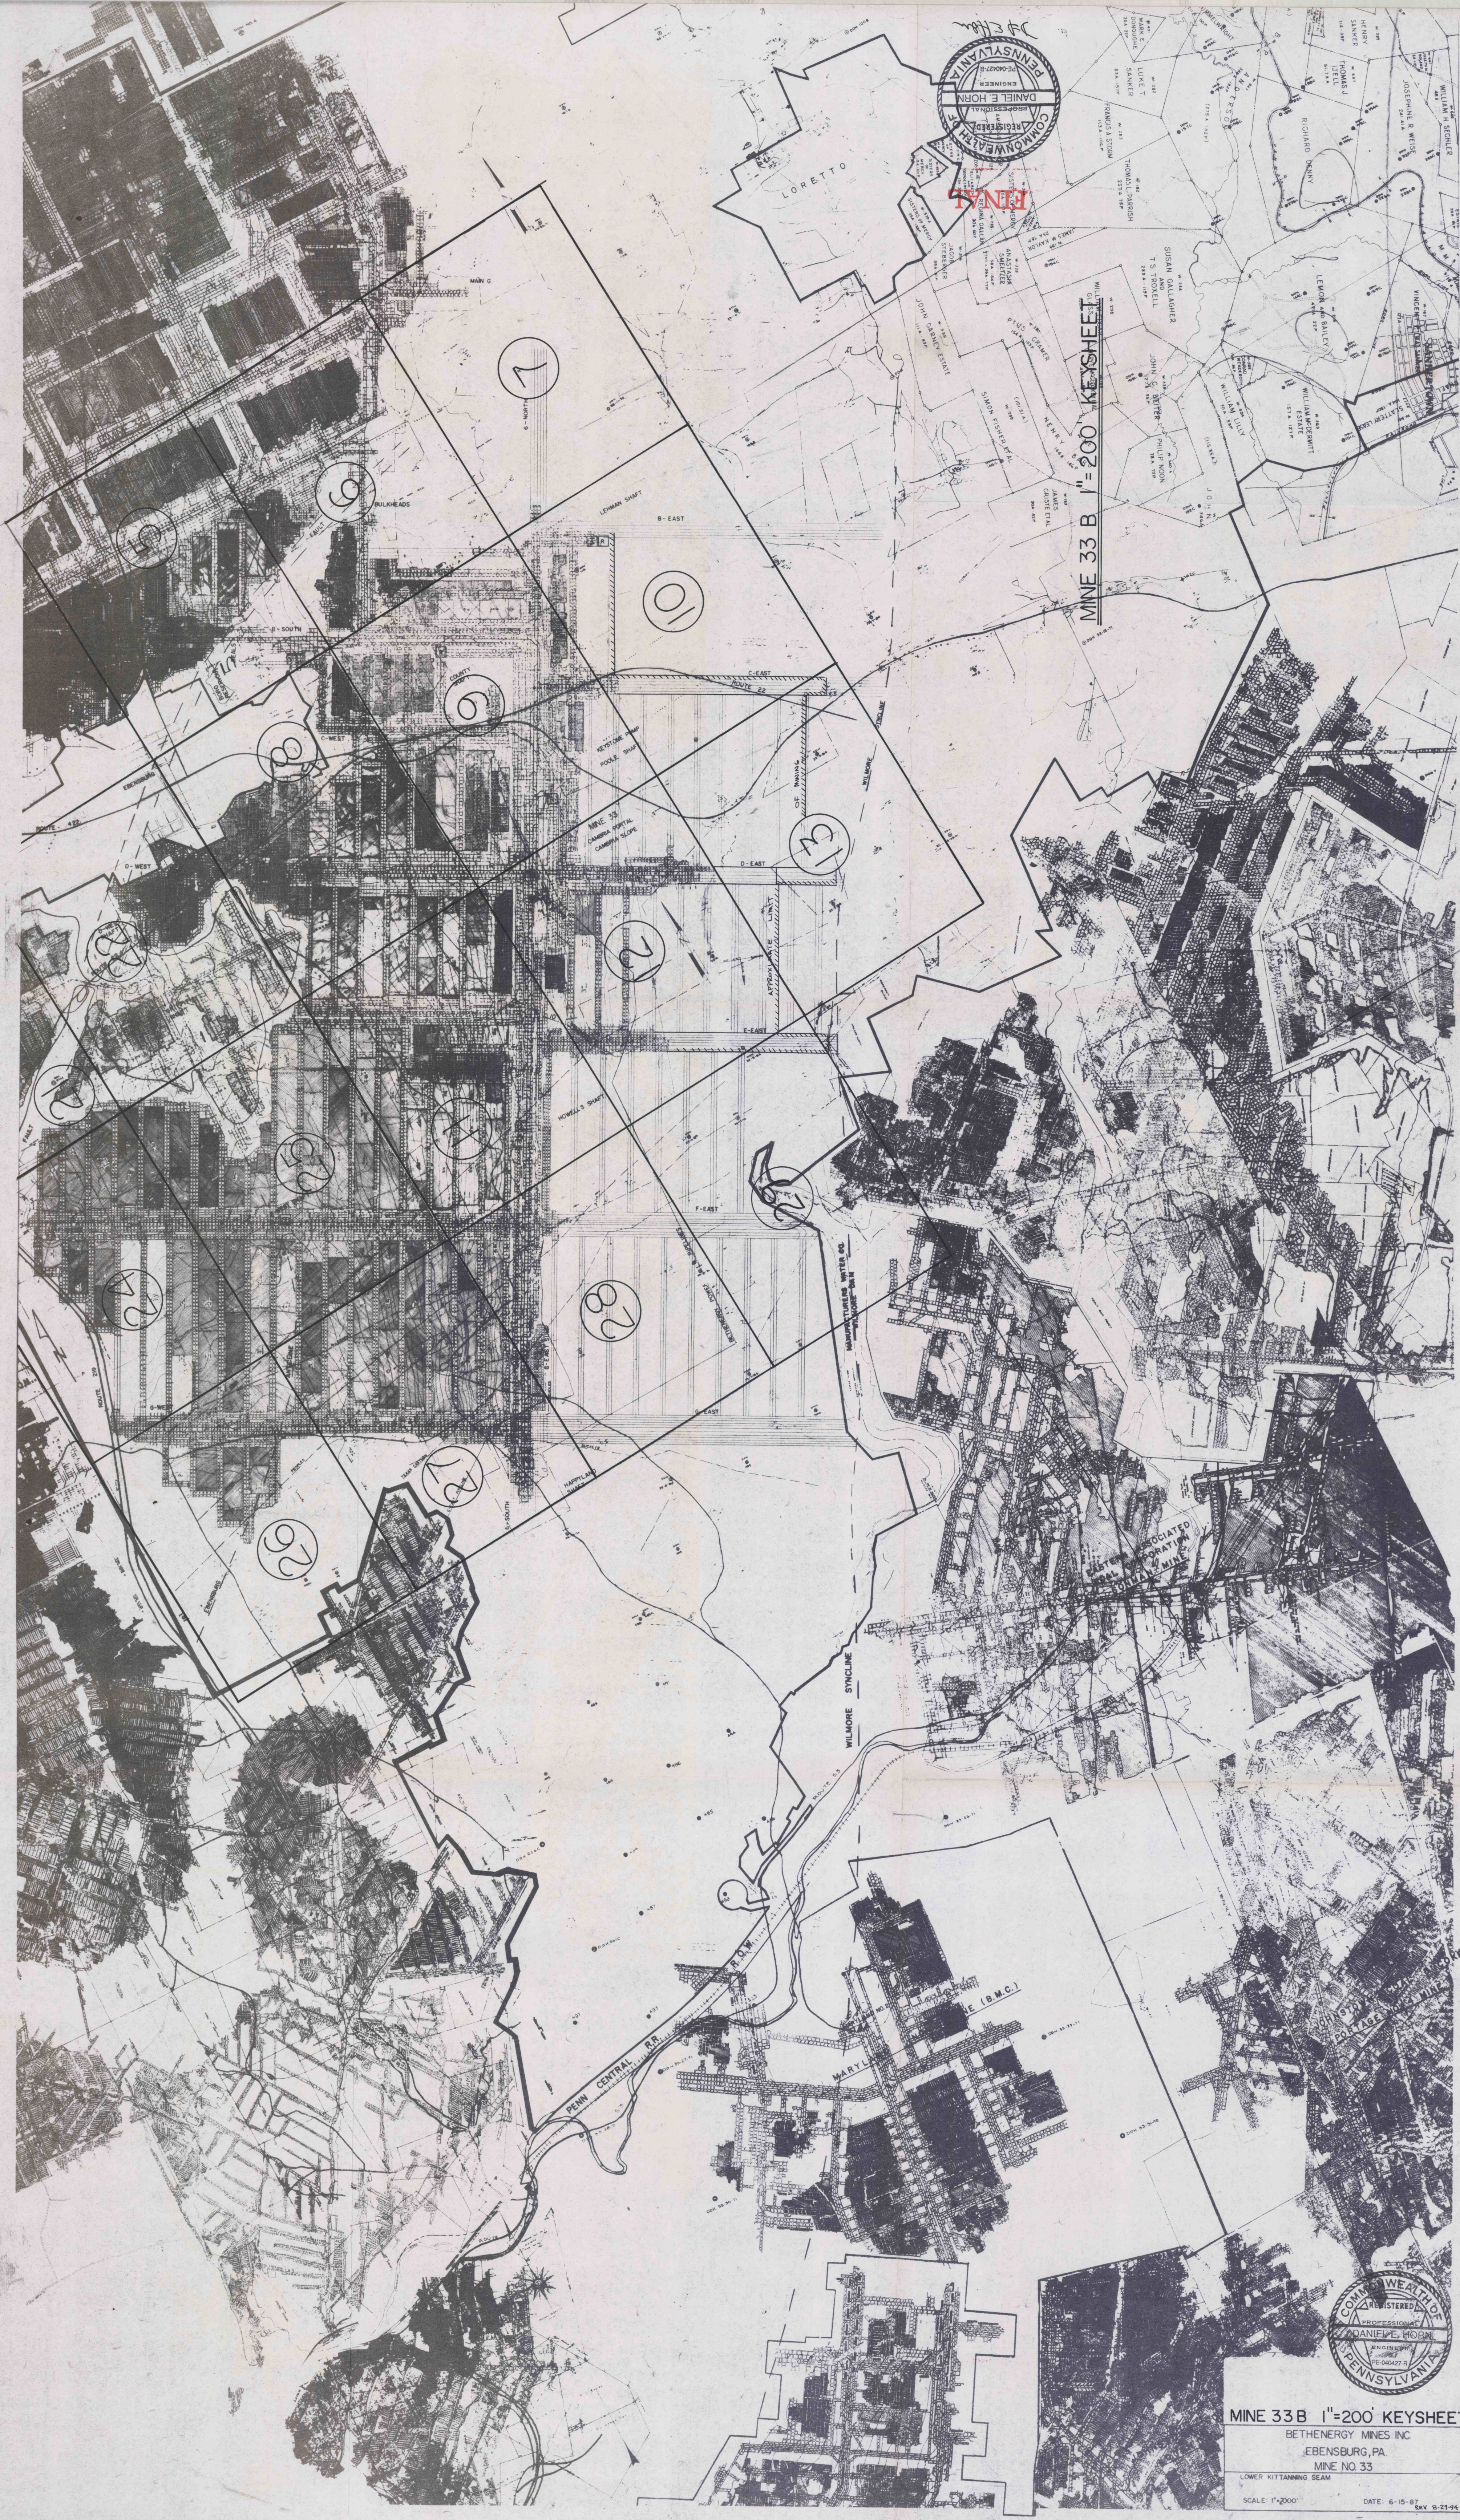

MINE 33 B 1"=200' KEYSHEET
BETHENERGY MINES INC
EBENSBURG, PA
MINE NO. 33
LOWER KITTANNING SEAM

SCALE: 1"=2000' DATE: 6-15-87 REV: 0-21-94