



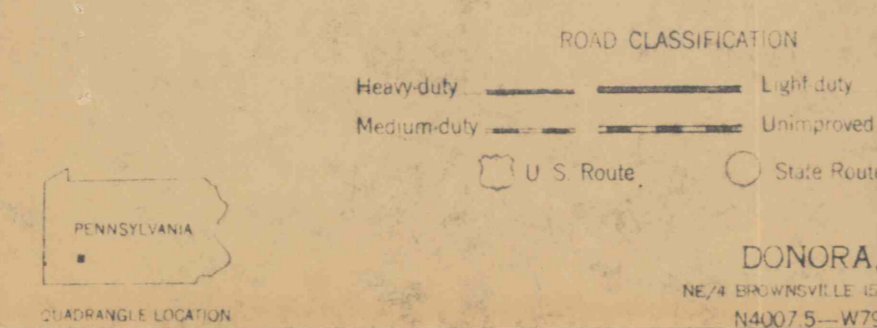



Republic Steel Corp.  
"Boring" 23-1961  
WES

PROPOSED  
3000 GPM  
DEEP WELL PUMP

edited and published by the Geological Survey  
USGS and USCGS  
by from aerial photographs by multiple methods  
surveys from 1952. Field check 1954.  
projection: 1927 North American datum  
in grid based on Pennsylvania coordinate system.  
displays areas which only  
buildings are shown  
1 step mine and mine dump areas

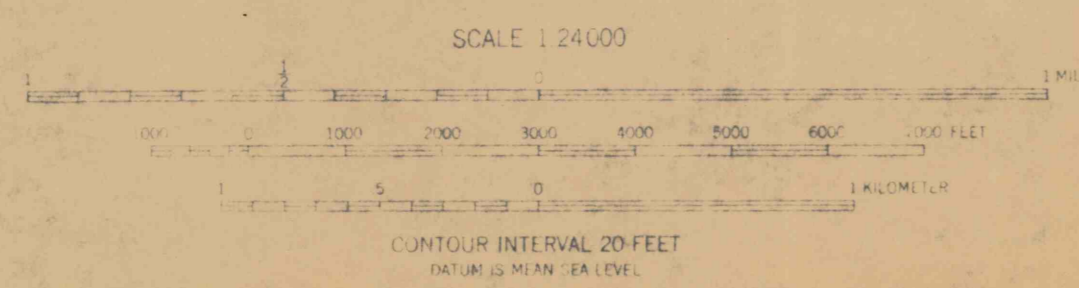

Map compiled, edited, and published by the Geological Survey  
by USGS and USCGS.  
Topography from aerial photographs by multiple methods  
local photogrammetric control. Field check 1954.  
Projection: 1927 North American datum  
10,000-foot grid based on Pennsylvania coordinate system  
south zone.  
compiled from 1952 aerial photography

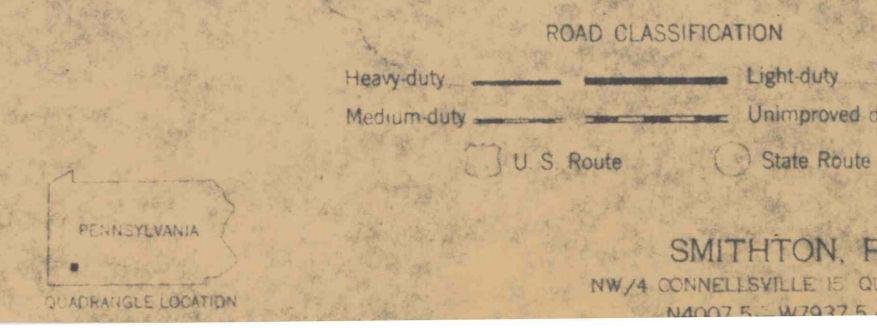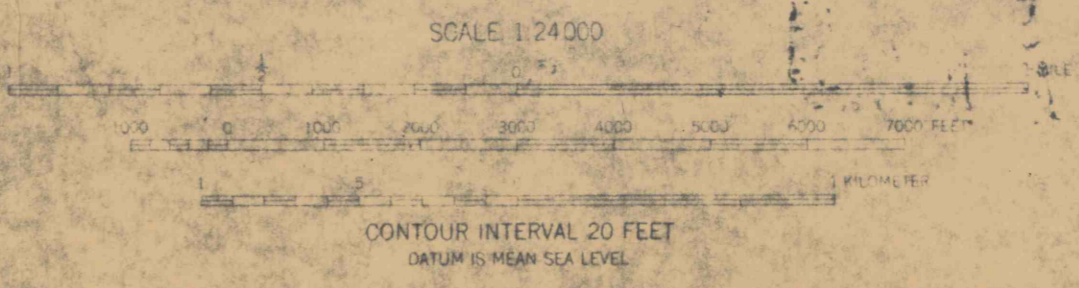

ROAD CLASSIFICATION  
Heavy-duty ——— Light-duty  
Medium-duty ——— Unimproved dirt  
U.S. Route      State Route

ROAD CLASSIFICATION  
Heavy-duty ——— Light-duty  
Medium-duty ——— Unimproved dirt  
U.S. Route      State Route