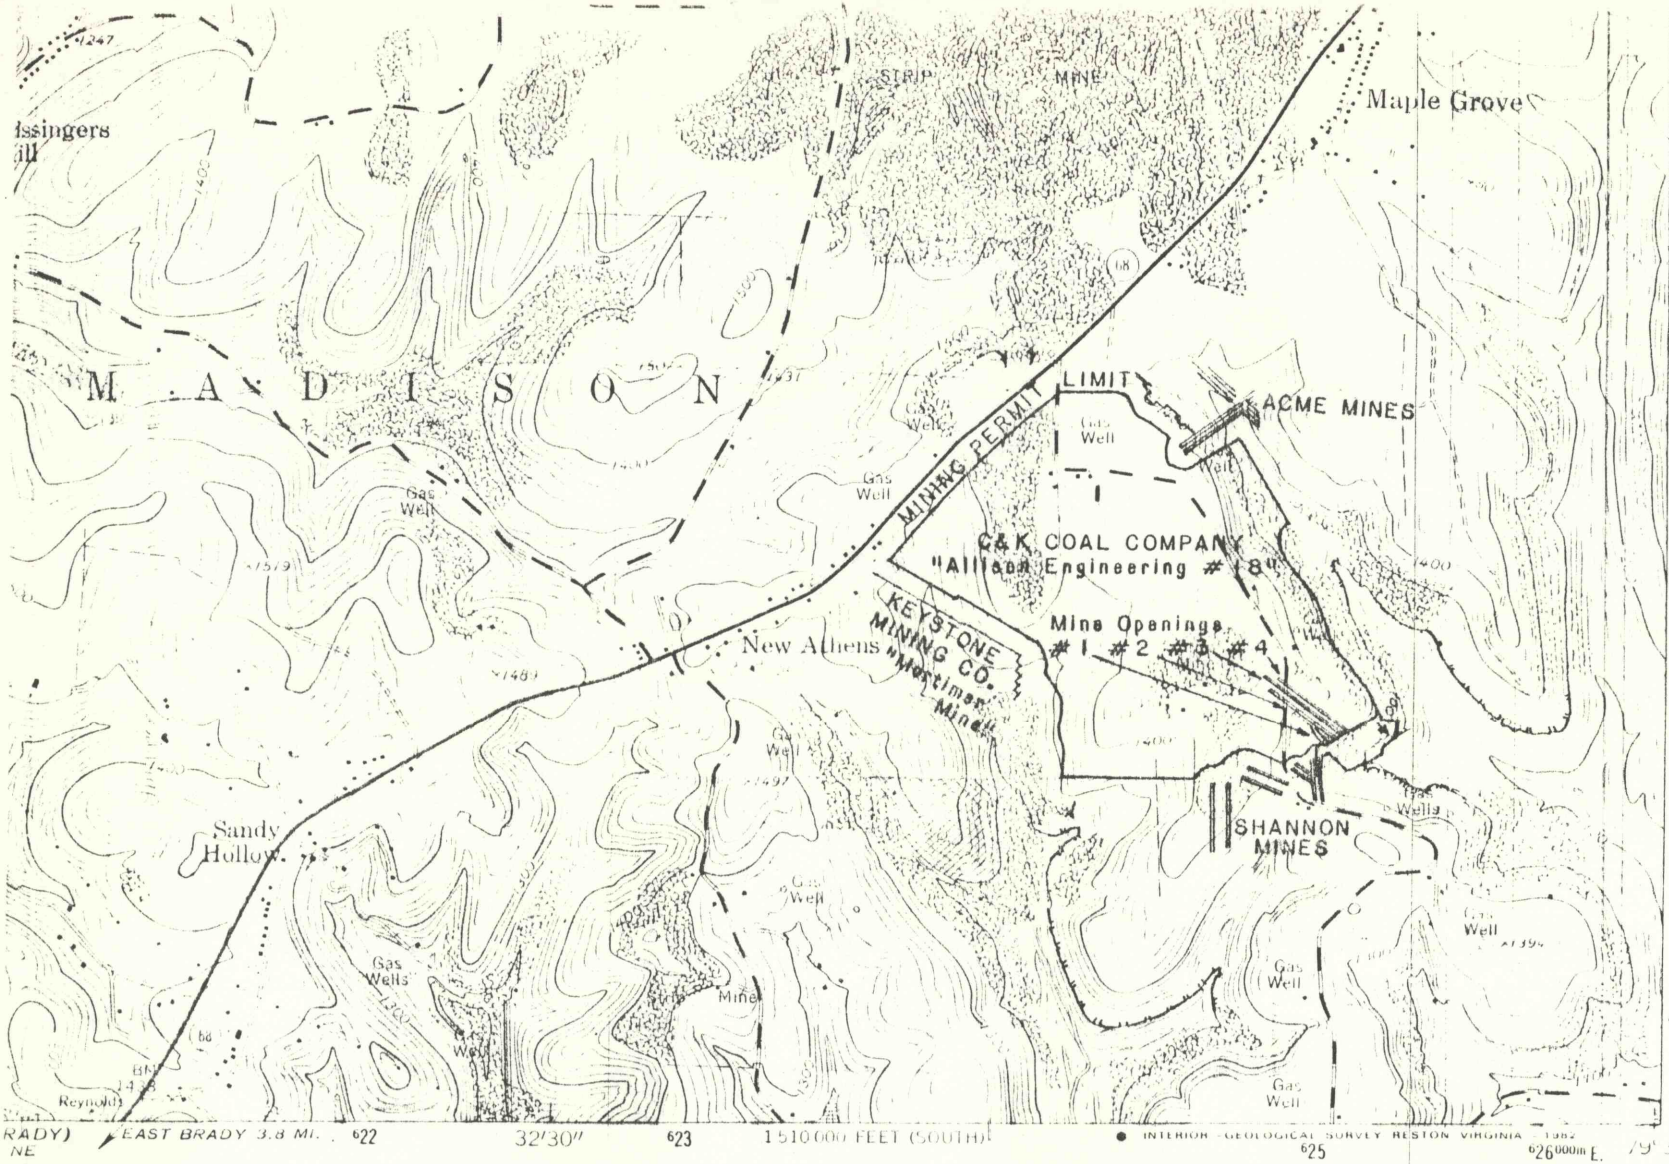

C & K COAL COMPANY

"Allison Engineering #18"

Madison Township, Clarion Co

May 21, 1984

Approx. Lower Kittanninmg Cropline

Country Bank Type Deep Mine

MINE OPENING	ELEV.
#1	1234.4
#2	1240.6
#3	1239.1
#4	1237.1

24000

1 MILE

4000 5000 6000 7000 FEET

1 KILOMETER

RVAL 20 FEET

TICAL DATUM OF 1929

32B

NAL MAP ACCURACY STANDARDS

URVEY, RESTON, VIRGINIA 22092

AND SYMBOLS IS AVAILABLE ON REQUEST

HAROLD FRANK SCOTT, P.E.

RD 2

RIMERSBURG, PA. 16248

ROAD CLASSIFICATION

Heavy duty — Light duty

Medium duty — Unimproved dirt

State Route

PENNSYLVANIA

QUADRANGLE LOCATION

RIMERSBURG, PA.

N4100—W7930/7.5

1963

PHOTOREVISED 1981

DMA 5066 II SE SERIES V831