

4543
620 000 FEET (SOUTH)
4542
4541
4540000m.N.
41°00'

RECEIVED

MAY 21 1984

ENVIRONMENTAL RESOURCES
Hoodville Regional Office

C & K COAL COMPANY

"Allison Engineering #18"

Madison Township, Clarion


May 21, 1984

Approx. Lower Kittanning Cropline

Country Bank Type Deep Min

MINE OPENING	ELEV.
#1	1234.4
#2	1240.6
#3	1239.1
#4	1237.1

EAST BRADY 3.8 MI. 622 32'30" 623 1510 000 FEET (SOUTH) 625 626000m.E. 79°30'

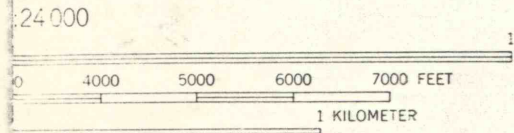


HAROLD FRANK SCOTT, P.E.
RD 2
RIMERSBURG, PA. 16248

ROAD CLASSIFICATION

Heavy-duty ——— Light-duty ———
Medium-duty ——— Unimproved dirt - - - - -
○ State Route

VERTICAL DATUM OF 1929

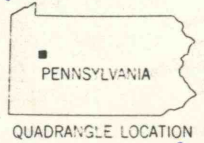

QUADRANGLE LOCATION

RIMERSBURG, PA.

N4100--W7930/7.5

1963
PHOTOREVISED 1981
DMA 5066 II SE--SERIES V831

Steve Mauerburg
68 N. on Rt 412 + mile Brady in West corner 1 mile up hang Hill

