


#3
URLING

INDEX FOR
1" = 400' MAPS

KEYSTONE COAL MINING CORP.
URLING #1 MINE

FINAL MINE MAP
POSTED 11/30/99

SCALE: 1" = 2,000'

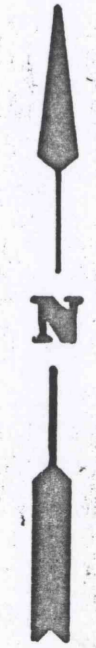

DMS04535

Sheet 8

is with

URLING #1

DMS04536