


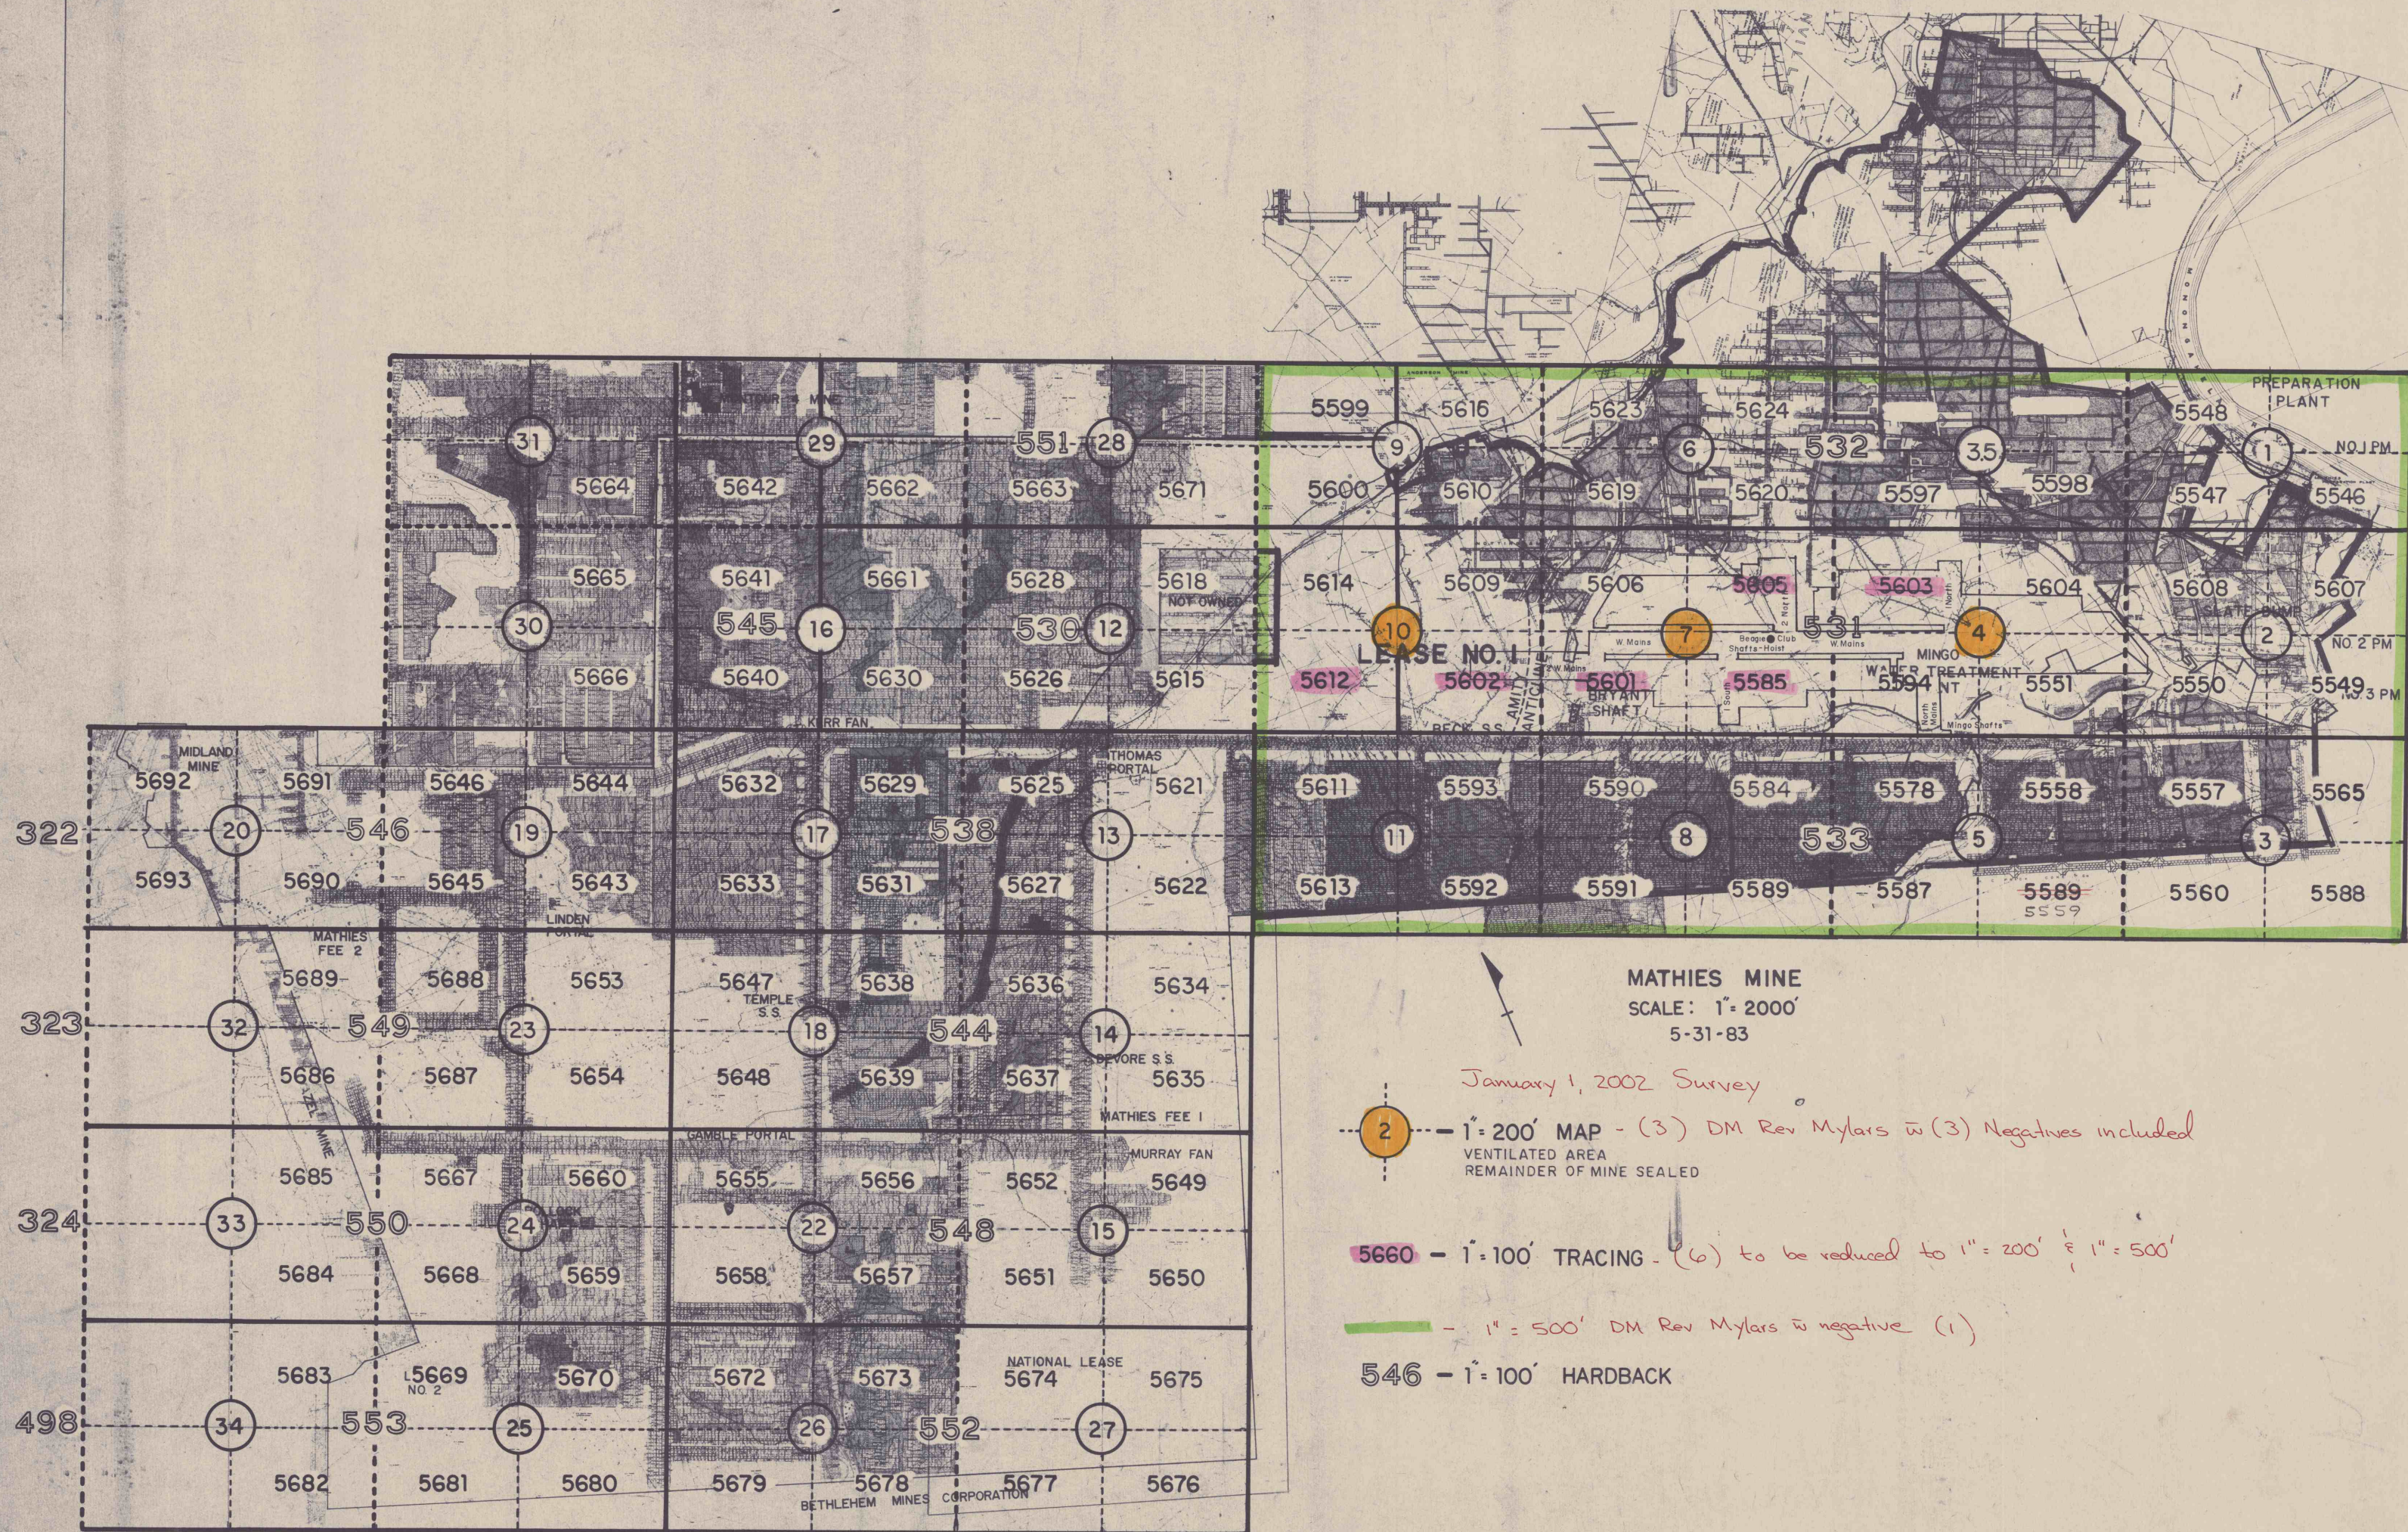

MATHIES MINE
SCALE: 1" = 2000'
5-31-83

January 1, 2002 Survey

2 - 1" = 200' MAP - (3) DM Rev Mylars w (3) Negatives included
VENTILATED AREA
REMAINDER OF MINE SEALED

5660 - 1" = 100' TRACING - (6) to be reduced to 1" = 200' & 1" = 500'

546 - 1" = 500' DM Rev Mylars w negative (1)

546 - 1" = 100' HARDBACK