
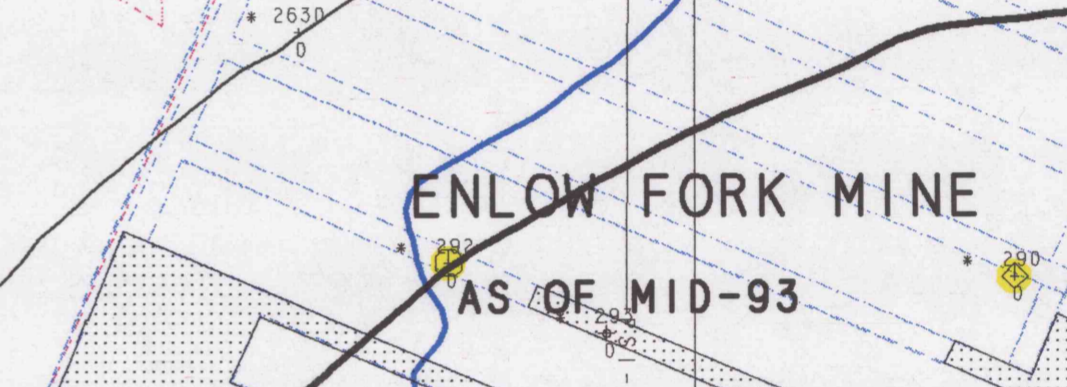


MAXIMUM PRESSURE REPORTED

OTHER WELLS		MAJORSV. DEEP WELLS	
●	HEARD STORAGE FIELD	●	INJECT-RECOV WELLS
●	MAJORSVILLE SHALLOW	●	SPECIAL WELLS
○	NON STORAGE WELLS	●	OBSERVATION WELLS
○	POINTS 2601-2630 FOR MODELING ONLY POINTS ARE NOT WELLS	○	CONSOL WELL NUMBER MAXIMUM WELL PRESSURE

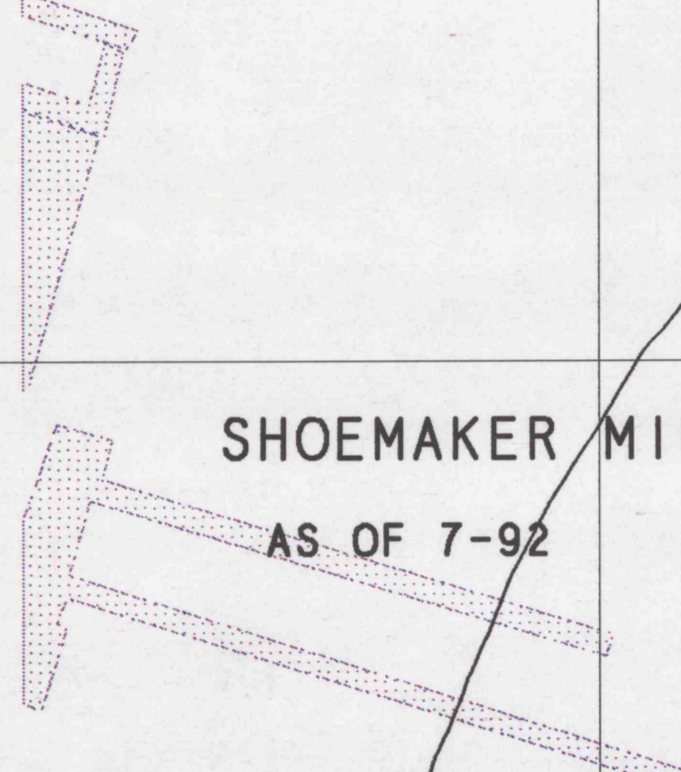

COMPRESSOR STATION

BAILEY MINE AS OF MID-93

RESERVOIR BOUNDARY

3000' PROTECTIVE ZONE

WEST VIRGINIA PENNSYLVANIA

CONSOL INC.
MAJORSVILLE DEEP FALL 94
MAX PRES ISOPAC WITH ZEROS
SCALE: 1" = 2000' SO
AUG. 1994 MDEEP.MAXPRES.FAL 94