


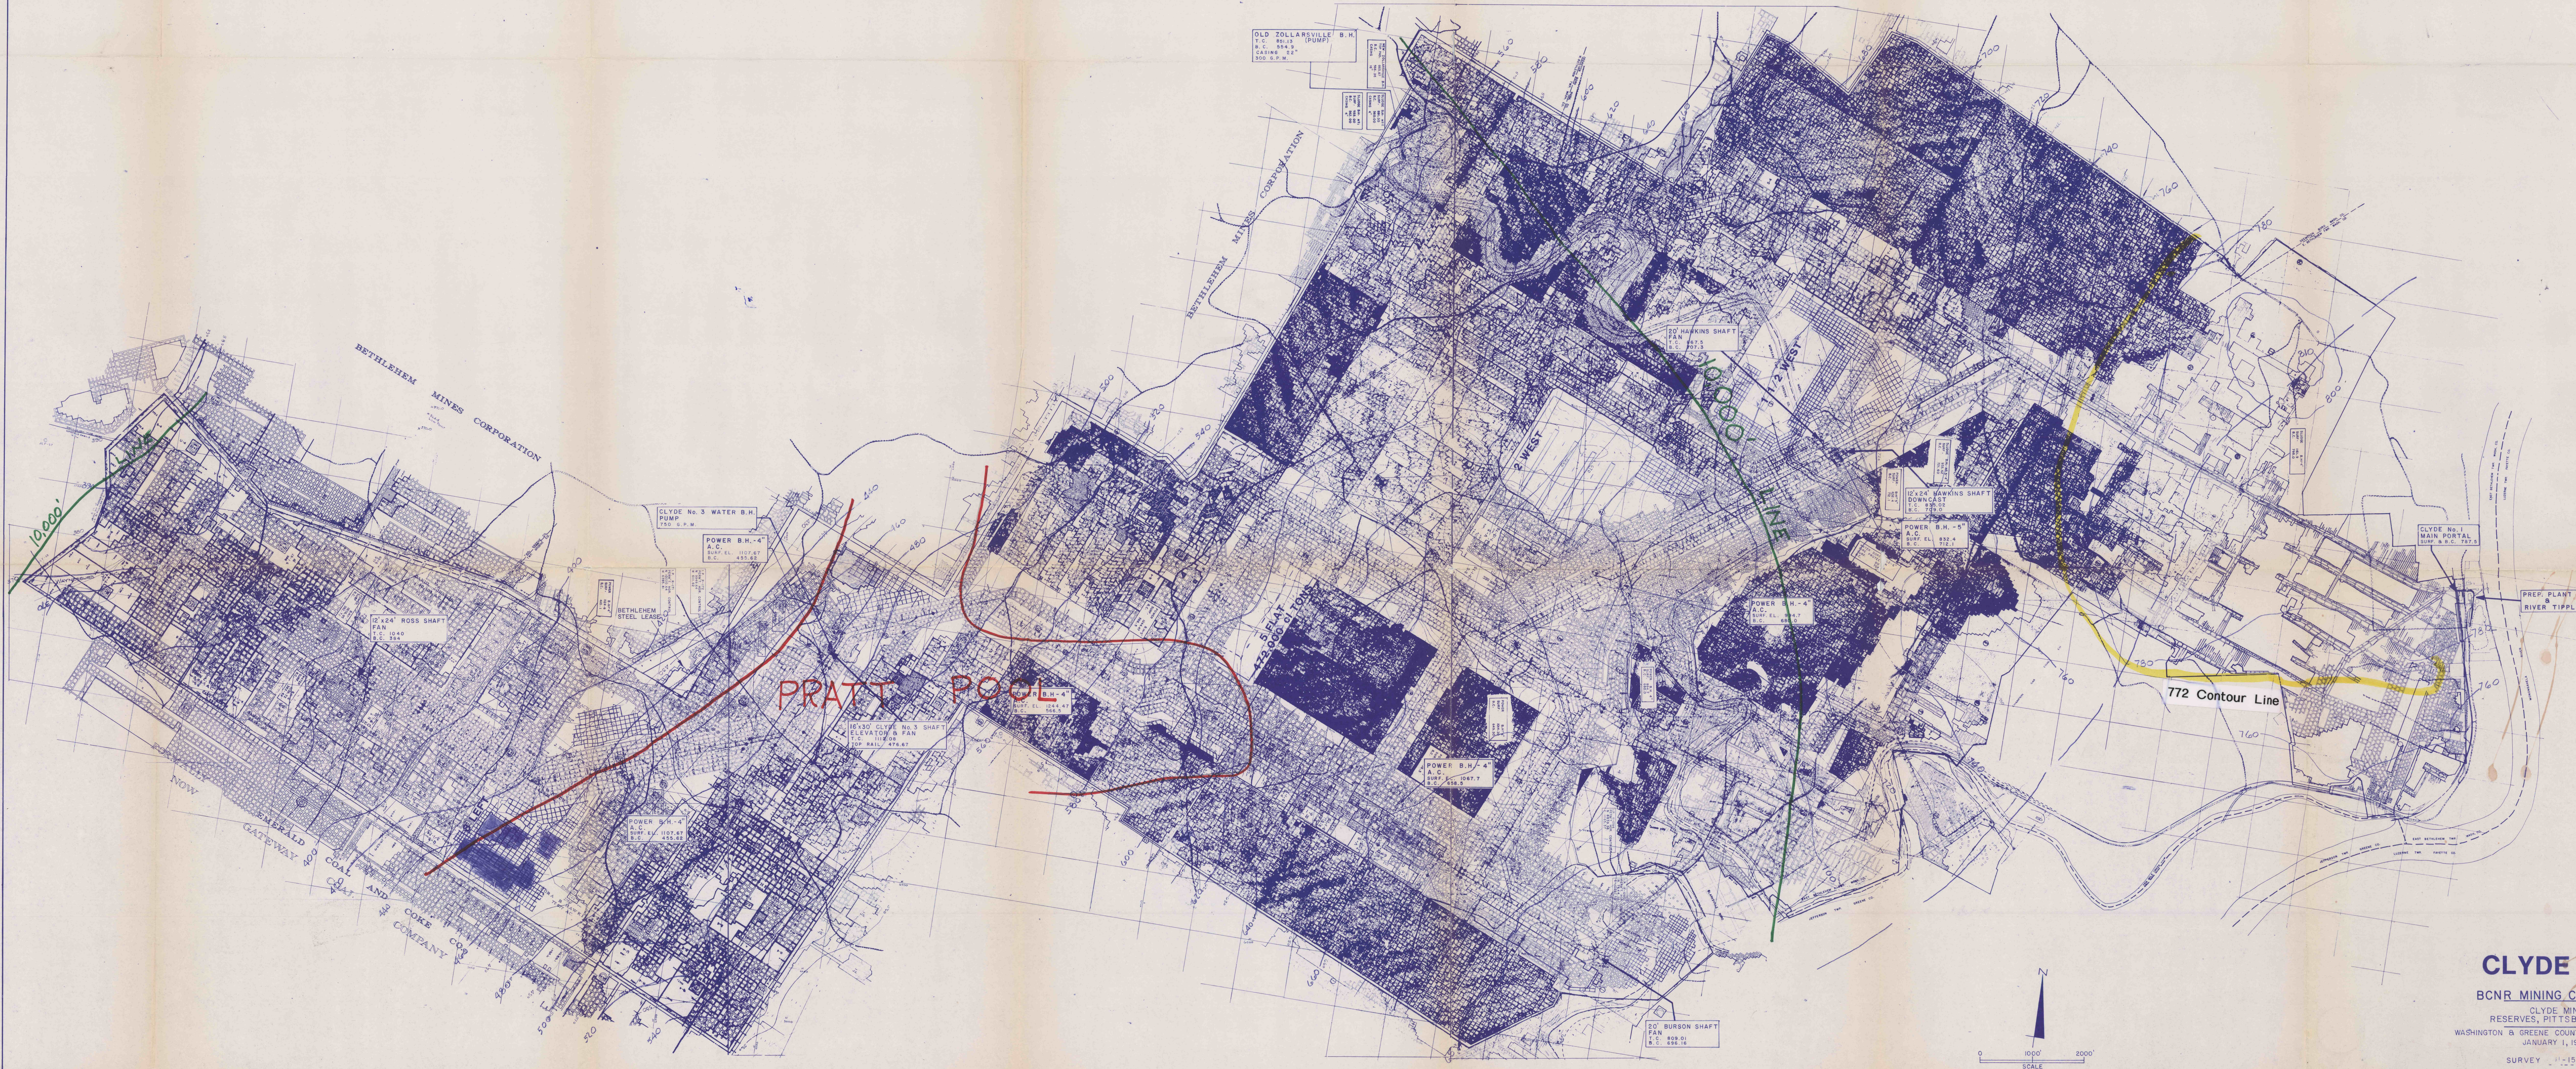

CLYDE MINE
BCNR MINING CORPORATION
CLYDE MINE
RESERVES, PITTSBURGH, BED
WASHINGTON & GREENE COUNTIES, PENNSYLVANIA
JANUARY 1, 1980
SURVEY 15-80

