
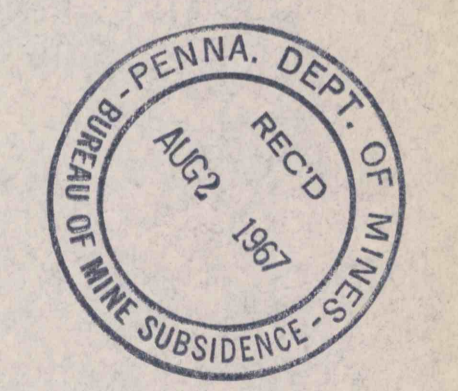
 AREA OF COMPLETED MINING JUNE 3, 1967  
 AREA OF PROPOSED MINING JUNE 3, 1967 TO DEC 3, 1967



MINE SUBSIDENCE MAP  
 FOR  
 ALLISON ENGINEERING COMPANY  
 ALLISON NO. 17 MINE  
 TOBY TWP. CLARION COUNTY  
 SCALE 1"=200' JULY 15, 1967



OFFICE COPY