




LAND & OPERATIONS
 OF
 FALL BROOK COAL CO.
 WEST OF
 ANTRIM

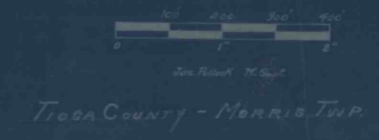




Full Brook Coal Co.
Mr. M. D. Dr. M. J.
75 Broadway, N.Y.
 1917

RECEIVED BY INSPECTOR
 DEPARTMENT OF REVENUE
 STATE OF PENNSYLVANIA
 HARRISBURG, PA., 5/18/17


Very respectfully yours,
John H. Kunkel
 Chief Inspector
 For the State