


MAP SHOWING LANDS OF S. HEGARTY SONS AND D SEAM DEEP MINE OPERATIONS OF J.E. LEVO AND CAMBRIA MILLS COAL CO. APPLE #4 MINE BECCARIA TWP. CLEARFIELD CO. PENNA. SEPT 21, 1939 J.L. BANFIELD REG. ENG.


**N° 5 REVISIONS**

1	JAN 1 - 1967
2	JULY 25 1967
3	JAN. 18 - 1968
4	JULY 31, 1968
5	FEB. 12, 1969
6	

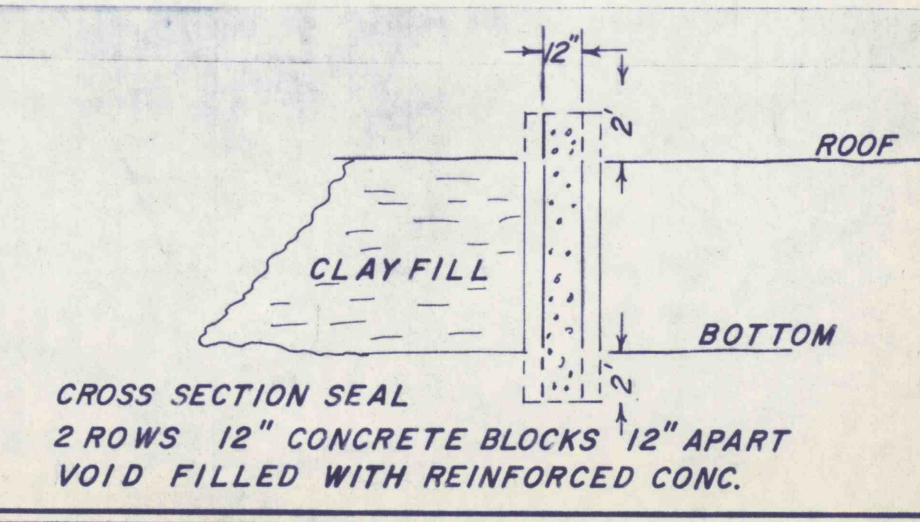

NOTE: COMPLETE MINING RIGHTS FOR ALL COAL HELD BY CAMBRIA MILLS COAL CO. INC.

MAP REVISED AS OF RECENT SURVEY 1968

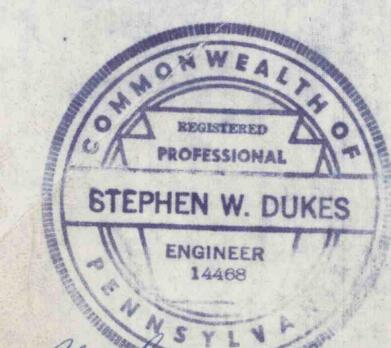

PROPERTY MAP  
**CAMBRIA MILLS COAL CO. INC.**  
SITUATE  
BECCARIA TWP, CLEARFIELD CO., PA  
JULY 14, 1966

SCALE 1" = 200'  
GWIN ENGINEERS, INC.  
CONSULTING ENGINEERS  
ALTOONA PENNSYLVANIA

SHEET NO. FIELD COPY 66-6-60

#71  
5-27-99  
C.C.