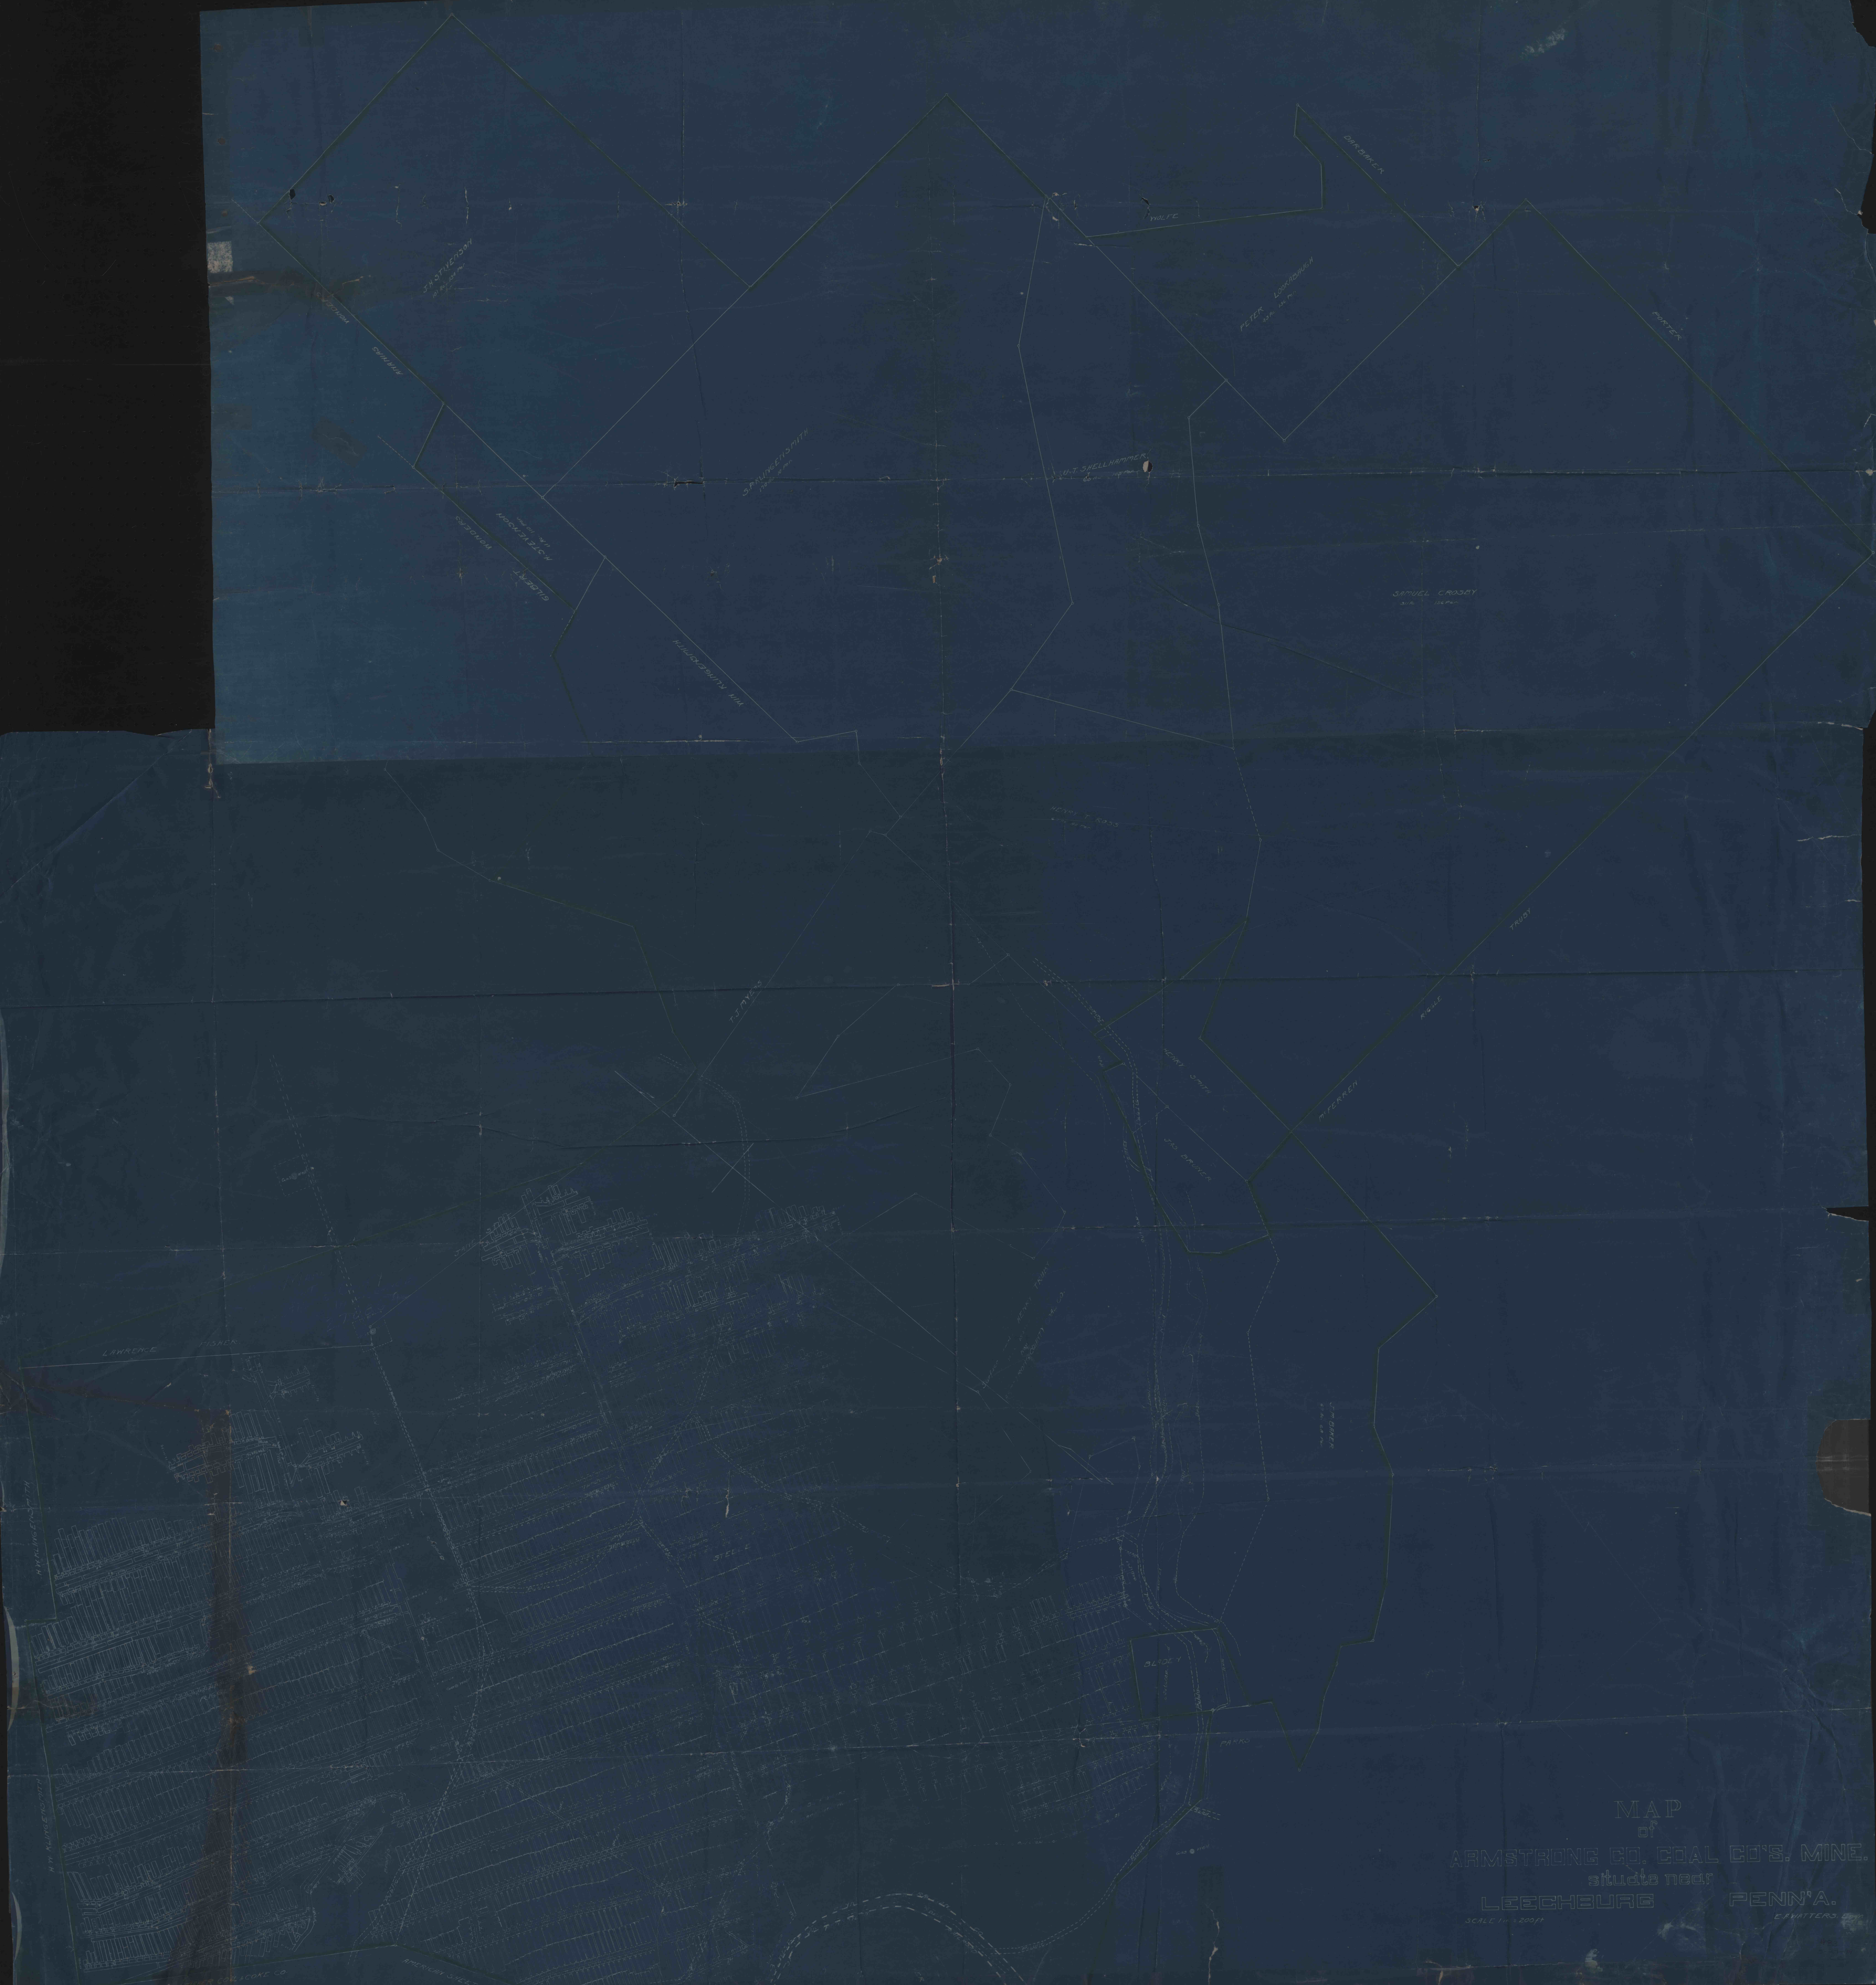
J.H. STEVENSON
WONDERS
H. STEVENSON
GILBERT
WM KLINGENSMITH
S.P. KLINGENSMITH
WOLFE
DARBAKER
PETER LOOKABAUGH
PORTER
U.T. SHELLHAMMER
SAMUEL CROSBY
HENRY T. ROSS
T.J. MYERS
LAWRENCE
FISHER
HENRY SMITH
JAS BRUNER
McFERREN
RIGGLE
TRUBY
HENRY TRUBY
J.M. BAKER
PARKS
STEELE
H.W. KLINGENSMITH
MAP
of
ARMSTRONG CO. COAL CO'S. MINE.
situate near
LEECHBURG PENN'A.
SCALE 1 in = 200 ft
E.F. WATTERS. Engr.