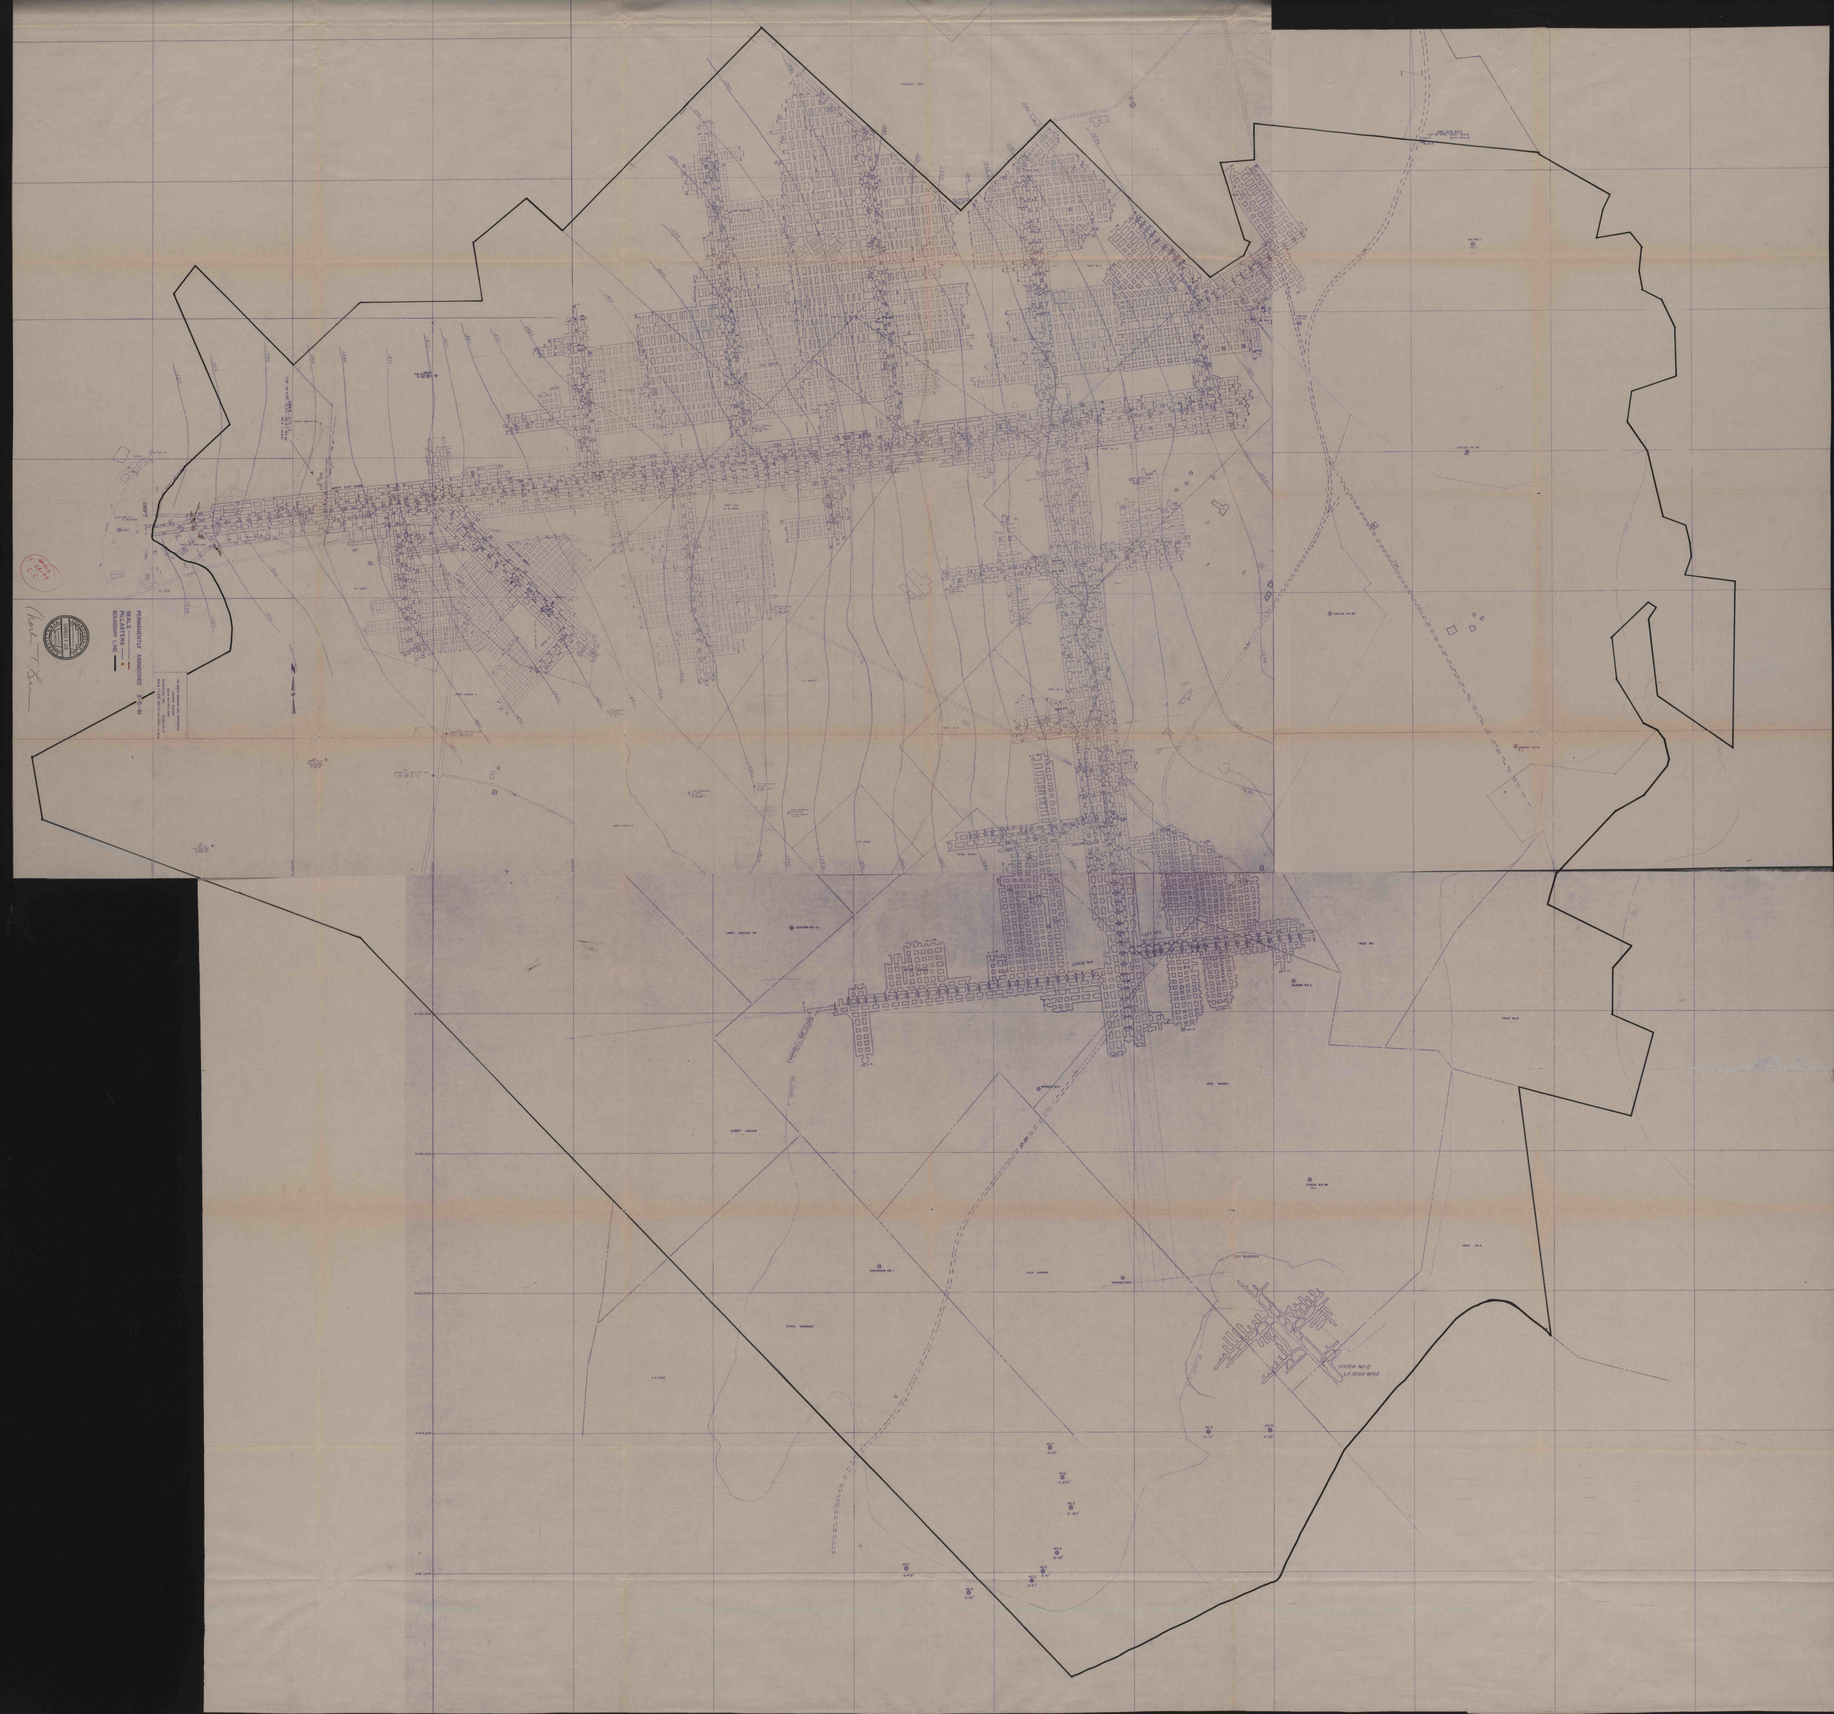
PERMANENTLY ABANDONED
PILLARTERS
BOUNDARY LINE
LARGE LOCATION 1M
LARGE 1M
LARGE 1M
LARGE LOCATION 1M
ALBERT LARGE
CHARLES LARGE
LARGE 1M
LARGE 1M
LARGE 1M