

VENTILATION LEGEND
I.D. No. 36-07045


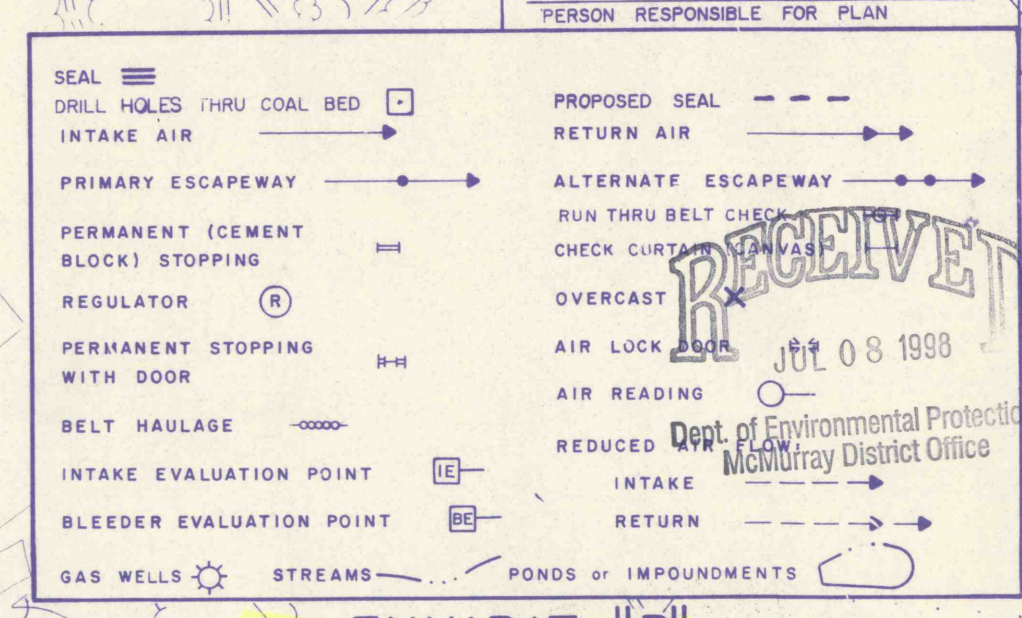


EXHIBIT "B"

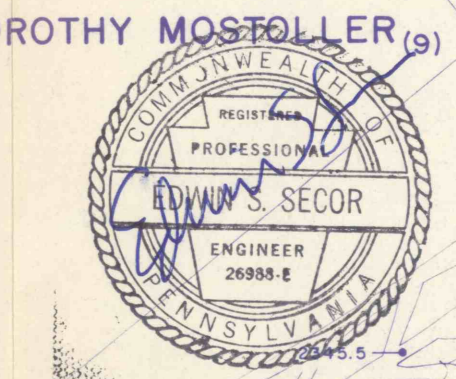

DOROTHY MOSTOLLER (9)

SURFACE PROPERTY INDEX

- 1. HAWKVIEW MINING CORPORATION (11)(1)
- 2. CAMERON KNEPPER (1)
- 22. LEE MUSHER (11)(1)
- 24. DEBORAH CUSTER (1)
- 25. HARRY FOTCHMAN (1)
- 27. DANNY RAY KIMMEL (1)
- 28. RAY KIMMEL (1)
- 29. STONYCREEK TOWNSHIP MOUNTAIN FIELD AND STREAM CLUB (1)(1)
- 30. EMMETT DUPPSTADT (1)
- 31. CARL LONG (1)(1)
- 32. LEO SLESMAN (1)(1)
- 33. ELMER MILLER (1)
- 36. GUY LOWE (1)
- 40. STEVEN KAWCHAK (1)
- 42. GEORGE STILL HEIRS (1)
- 45. JERRY ZERFOS (1)
- 46. ROBERT W. SNYDER (1)(1)
- 47. SARA NORRIS (1)
- 68. CLAIR WALKER, JR. (1)

KEY TO MINERAL OWNERSHIP

- (1) PBS COALS, INC.
- (2) GLENDON HILLEGASS
- (3) EMMA CARVER
- (4) NATHANIEL BARBERA
- (5) MILTON LOBBY
- (6) PENN. POCAHONTAS COAL COMPANY
- (7) NEVIN HILLEGASS
- (8) CLAYTON BRANT
- (9) DOROTHY MOSTOLLER
- (10) EMMETT DUPPSTADT
- (11) MERLE SNYDER
- (12) PONFEIGH LAND & MINING CO.
- (13) PENNSYLVANIA TURNPIKE COMMISSION

DOROTHY MOSTOLLER (9)

- A (1) 27,595 c.f.m.
- I (2) 2,500 c.f.m.
- R (3) 2,275 c.f.m.
- R (4) 2,275 c.f.m.
- E (5) 2,275 c.f.m.
- A (6) Perceptible Movement 0.00% Methane
- D (7) Perceptible Movement 0.00% Methane
- I (8) 2,275 c.f.m.
- N (9) Perceptible Movement 0.00% Methane
- S (10) Perceptible Movement 0.00% Methane
- (11) 11,765 c.f.m. — 0.00% Methane
- (12) 27,740 c.f.m. — 0.00% Methane
- (13) c.f.m. — 0.00% Methane
- (14) 3,704 c.f.m. — 0.00% Methane
- (15) 13,040 c.f.m. — 0.00% Methane
- (16) Perceptible Movement 0.00% Methane
- (17) Perceptible Movement 0.00% Methane
- (18) 2,275 c.f.m.
- (19) 2,275 c.f.m.
- (20) 2,275 c.f.m.

Prepared For
RoxCOAL, INC.

BARBARA NO. 1 MINE Final Map
Upper Kittanning Coal Seam
Site

STONYCREEK TWP.,
SOMERSET CO., PENNSYLVANIA

Scale: 1" = 200'
DATE: JUL 01 1998

MODULE 22 PAGE 22