

JAMES KAWCHAK(1)

RICHARD BRANT (1)(3)

WINDBER HIGH STANDARD COAL CO., INC.

RAY CARVER (1)(3)

4th Right Butt

Emmett Dupstadt Strip

MINING COMPLETED

2nd Right Butt

BLANCHE LONG(1)


ROBERT L. SNYDER (1)(8)

DOROTHY MOSTOLLER (9)

Kotrick Mine

Shipley Mine

Thermal Coal Company Strip

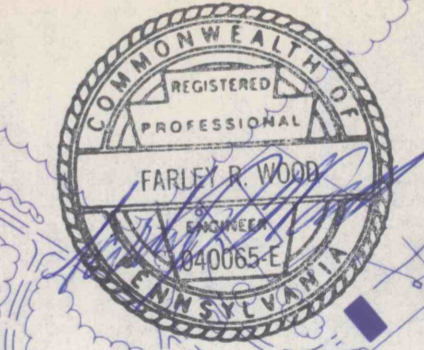

VENTILATION LEGEND  
I.D. No. 36-07049

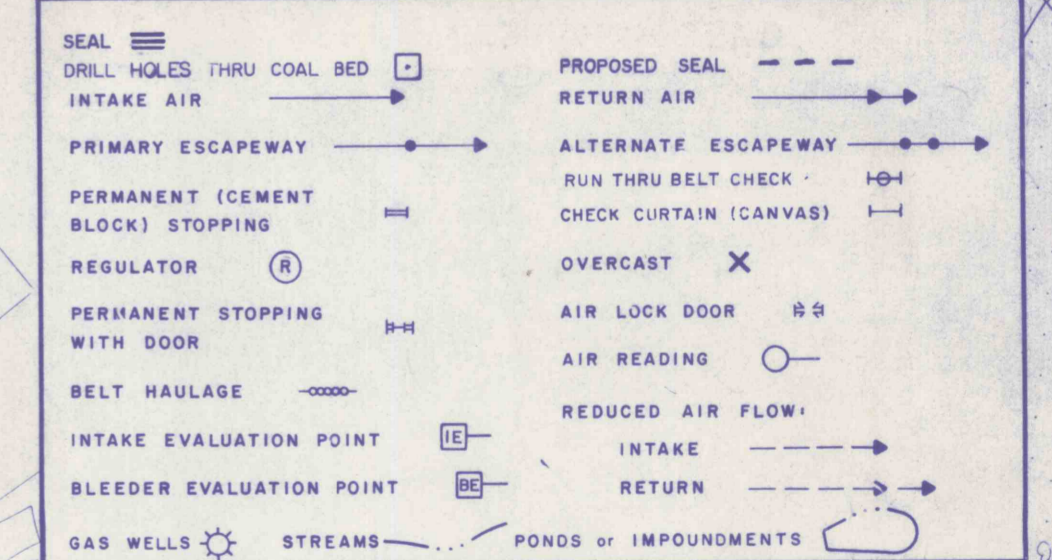


EXHIBIT B

Areas surveyed by Hawkview Mining Corporation personnel

A	1	47,595 cfm	
I	2	6,710 cfm	
R	3	46,656 cfm	
R	4	102,466 cfm	0.00% Methane
E	5	20 cfm	0.00% Methane
A	6	Perceptible Movement	0.00% Methane
D	7	13,903 cfm	0.00% Methane
I	8	3,703 cfm	0.00% Methane
N	9	Perceptible Movement	0.00% Methane
G	10	748 cfm	0.00% Methane

11	5,060 cfm	0.00% Methane
12	2,508 cfm	0.00% Methane
13	12,500 cfm	
14	39,304 cfm	0.00% Methane
15	13,040 cfm	0.00% Methane
16		
17		
18	25,800 cfm	
19	3,876 cfm	20.9 % O <sub>2</sub>
20	9,840 cfm	0.00% Methane

SURFACE PROPERTY INDEX

- HAWKVIEW MINING CORPORATION (2)(13)
- CAMERON KNEPPER (1)
- LEE MUSSER (1)(3)
- DEBORAH CUSTER (1)
- HARRY FOTCHMAN (1)
- DANNY RAY KIMMEL (1)
- RAY KIMMEL (1)
- STONYCREEK TOWNSHIP MOUNTAIN FIELD AND STREAM CLUB (1)(13)
- EMMETT DUPPSTADT (1)
- CARL LOGUE (1)(3)
- LEO SLEASMAN (1)(13)
- ELMER MILLER (1)
- GUY LONG (1)
- STEVEN KAWCHAK (1)
- GEORGE STULL HEIRS (1)
- JERRY ZERFOS (1)
- ROBERT W. SNYDER (1)(9)
- GARY NORRIS (1)
- CLAIR WALKER, JR. (1)

KEY TO MINERAL OWNERSHIP

- PBS COALS, INC.
- GLENDON HILLEGASS
- EMMA CARVER
- NATHANIEL BARBERA
- MILTON LOWRY
- PENN POCAHONTAS COAL COMPANY
- NEVIN HILLEGASS
- GLADYS BRANT
- DOROTHY MOSTOLLER
- EMMETT DUPPSTADT
- MERLE SNYDER
- PONFEIGH LAND & MINING CO.
- PENNSYLVANIA TURNPIKE COMMISSION

Prepared For  
**RoxCOAL, INC.**

**BARBARA NO. 1 MINE**  
Upper Kittanning Coal Seam

Site at  
**STONYCREEK TWP., SOMERSET CO., PENNSYLVANIA**

Scale: 1" = 200'

DATE: 7-7-93

FINAL MAP SEAL PLAN

SHEET 1 OF 7