




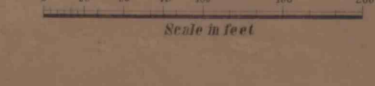

**SUBTERRANEAN**  
**MAP**  
 of the  
 BARCLAY COAL MINES  
 IN  
**FRANKLIN TWP.**  
**BRADFORD COUNTY PENNA.**  
 FROM  
 Walkers and Frisbie's Surveys  
 DRAWN BY  
 Z. F. WALKER  
 August 1861

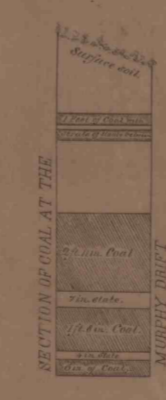

**EXPLANATION**  
 The lines showing the extent of the mines...  
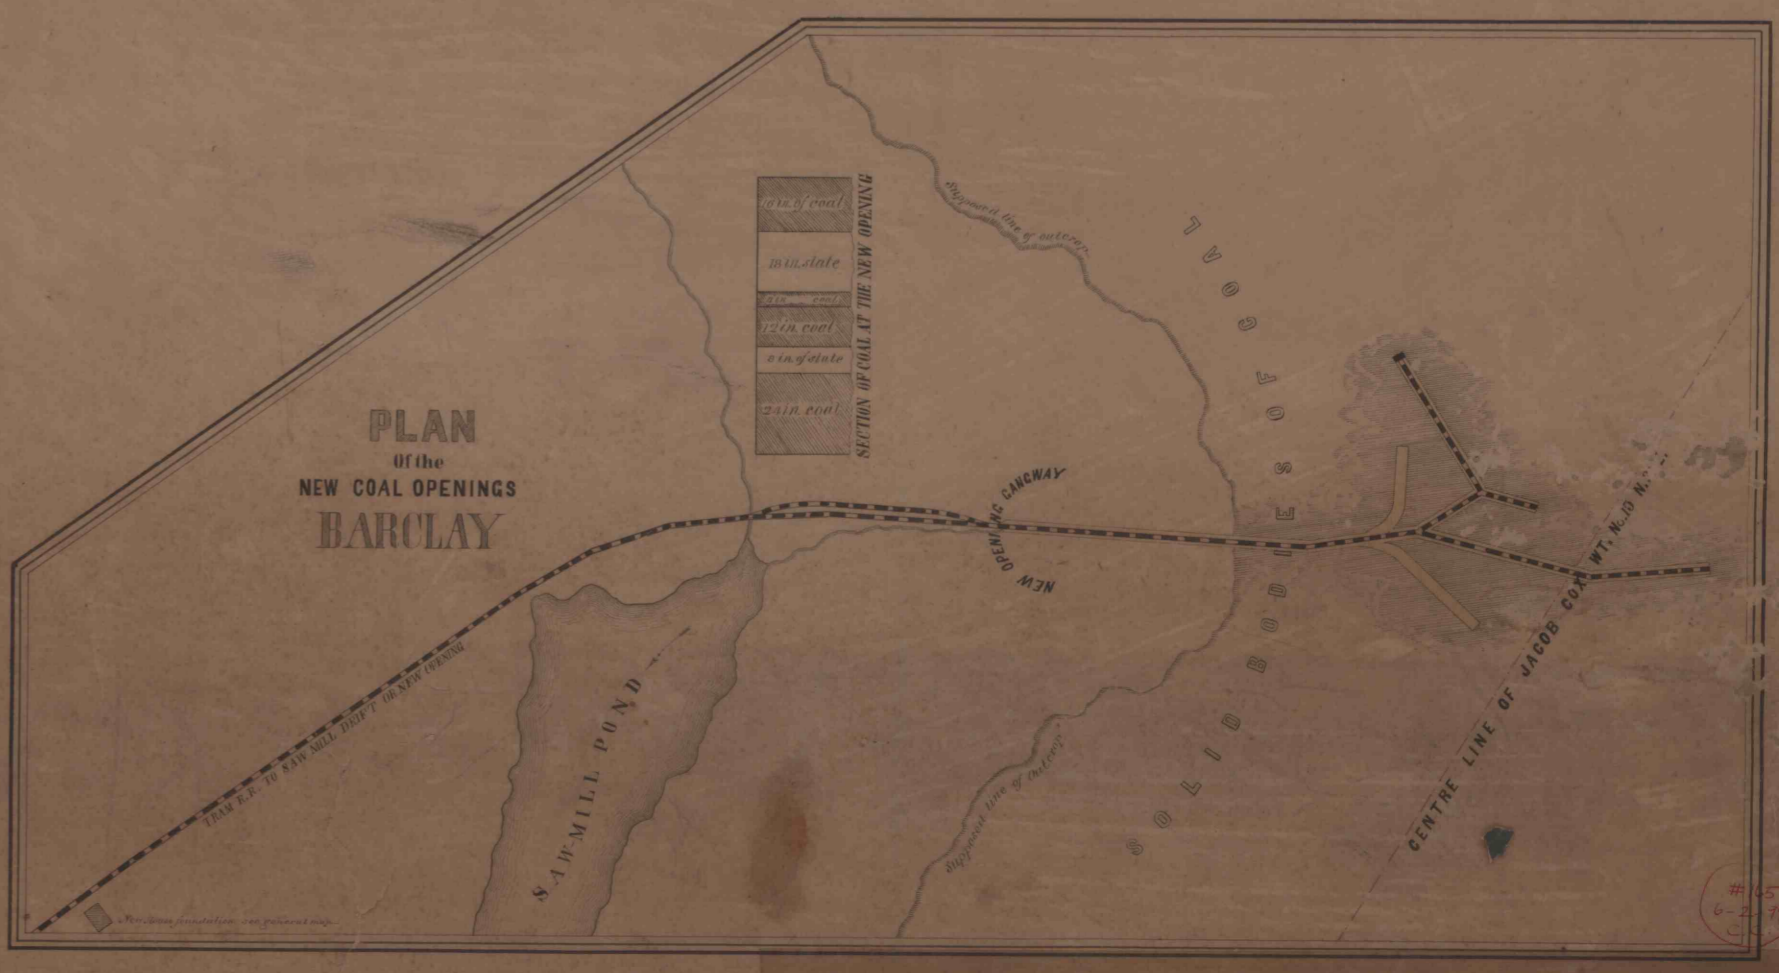

