


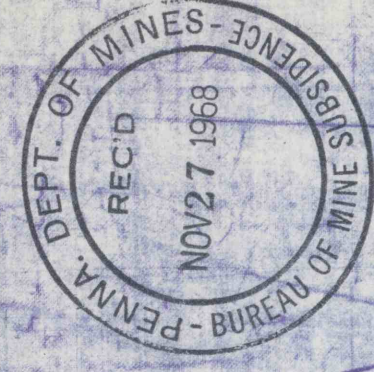

FIELD COPY



NEW BERNARD BROS MINE NO 1  
**REED COAL MINING Co.**  
 MINE NO 1


WEST CARROLL TWP CAMBRIA COUNTY PA,  
 Village of Bakerston - Elmora Pa.  
 3-13-1947  
 3-15-1948  
 9-15-1948  
 5-21-44  
 11-6-1948  
 4-11-1951  
 3-19-51

Master & Kinloch PE

#230-1  
 4-20-69

PERMIT 230-1 PROJ. NO. 3  
 NOV. 15, 1968 - MAY 15, 1969

W. K. ...

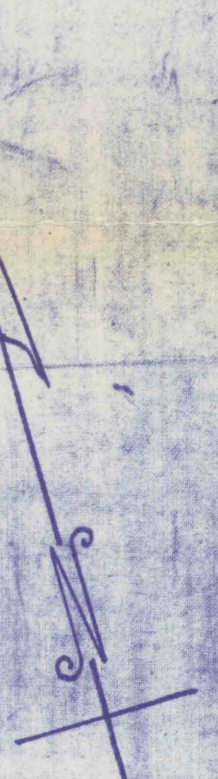

awrence Konforchick  
 0-77146