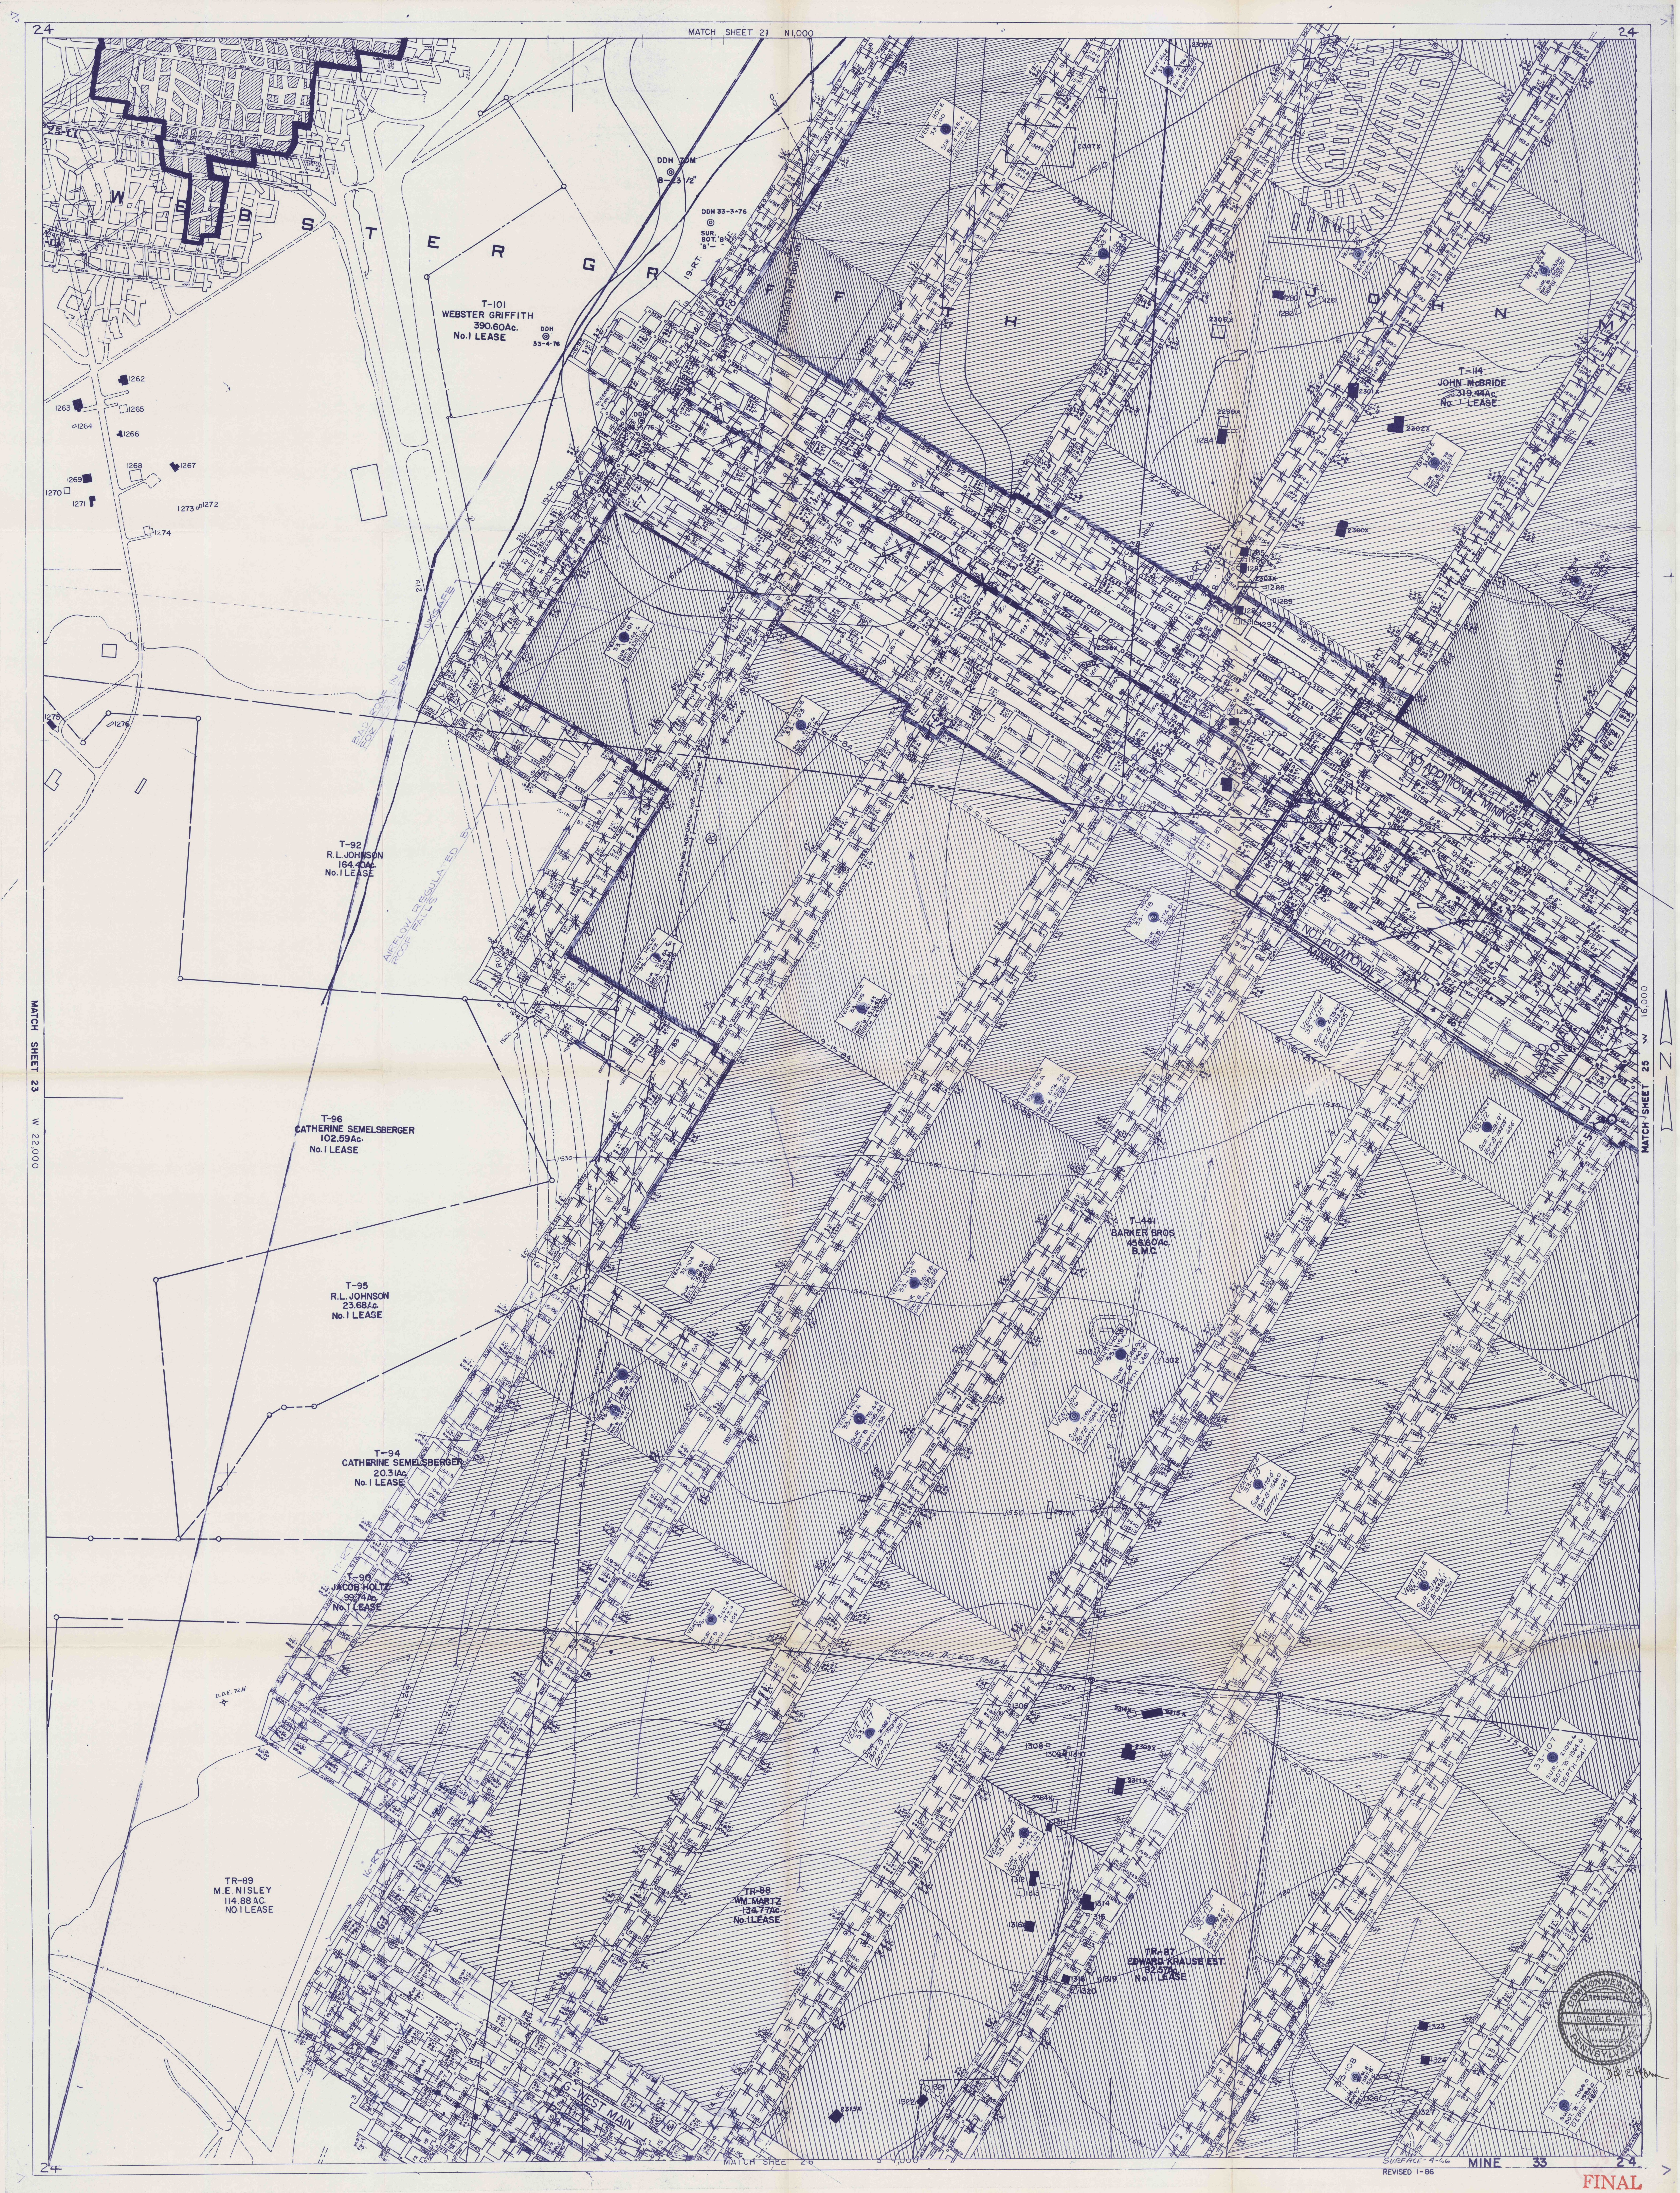

SURFACE - 4-66

REVISED 1-86

MINE 33 24

DANIEL E. HORN

PE-040427-R

FINAL