

PREPARED BY
Aerial Map Service Co.
PITTSBURGH, PENNA.


SHEET	INDEX
3	4
1	2

- UNPAVED ROAD
- == PAVED ROAD
- +— RAILROAD
- ~ LAKE, POND
- - - FENCE
- Woods LINE
- △ D-4 TRAVERSE STATION
- x 975 SPOT ELEVATION
- 2600 SURFACE CONTOURS
- 2500 SURFACE CONTOURS
- 2300 COAL CONTOURS
- LIMIT OF MINING BARRIER
- B-7 DRILL HOLE
- or □ OCCUPIED DWELLING
- BARN, GARAGE, SHED, etc.

SCALE 1" = 200'

DATE OF PHOTOGRAPHY NOV. 11, 1974

- TOWNSHIP LINE
- NEGRO MTN. ANTICLINE
- BARREN AREA

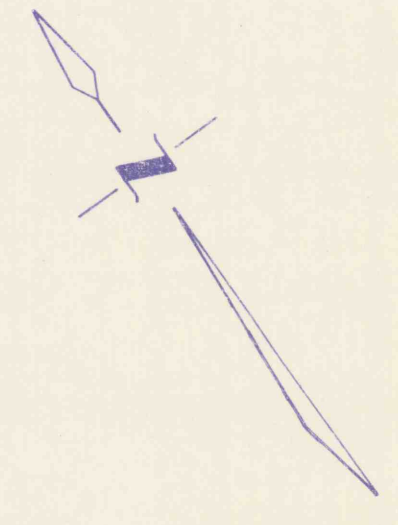

PENN POCAHONTAS COAL CO.

BLACK MOUNTAIN MINE

BROTHERSVALLEY TWP. SOMERSET COUNTY PA.

DATE: SEPT. 11, 1981 SCALE: 1" = 200'

REMARKS: MINING COMPLETED AT TIME OF TEMPORARY ABANDONMENT

#284
#11-99
C.C.

9-14-81