
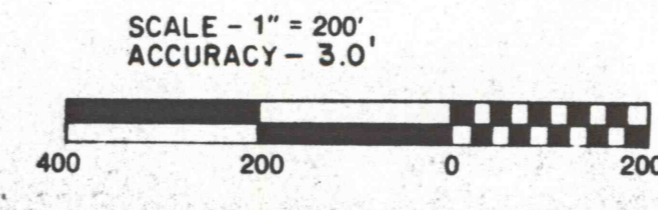


THIS MAP PREPARED BY L. ROBERT KIMBALL & ASSOCIATES  
 Consulting Engineers & Architects, EBENSBURG, PENNSYLVANIA  
 BY PHOTOGRAMMETRIC METHODS FROM AERIAL PHOTOGRAPHY  
 DATED APRIL 3, 1980

5	6	C
8	9	D
	12	E
		F

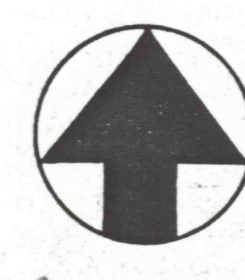

SIGNATURE & SEAL OF ENGINEER

**RECEIVED**  
 APR 24 1987  
 Dept. of Environmental Resources  
 McMurray District Office

**STANFORD MINING COMPANY**  
 P.O. BOX 188 OXONVILLE, PA. 15734  
 (412) 465-5623

**CHESTNUT RIDGE MINE**  
 CHERRYHILL TWP., INDIANA COUNTY, PENNA.  
 LOWER KITTANNING SEAM

FINAL MAP

SCALE 1" = 200'  
 DATE PREPARED: 2-23-87