


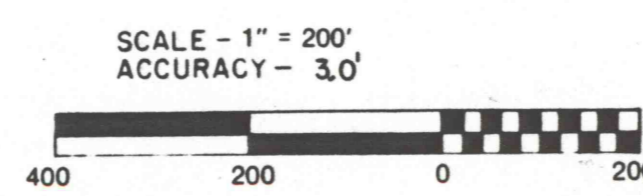

THIS MAP PREPARED BY L. ROBERT KIMBALL & ASSOCIATES  
 Consulting Engineers & Architects, EBENSBURG, PENNSYLVANIA  
 BY PHOTOGRAMMETRIC METHODS FROM AERIAL PHOTOGRAPHY  
 DATED APRIL 3, 1980

8	9
11	12
13	14



SIGNATURE & SEAL OF ENGINEER




STANFORD MINING COMPANY  
 P.O. BOX 188  
 DIXONVILLE, PA. 15734  
 (412) - 465-5621

CHESTNUT RIDGE MINE  
 CHERRYHILL TWP., INDIANA COUNTY, PENNA.  
 LOWER KITTANNING SEAM



APR 24 1987  
 Dept. of Environmental Resources  
 McMurray District Office

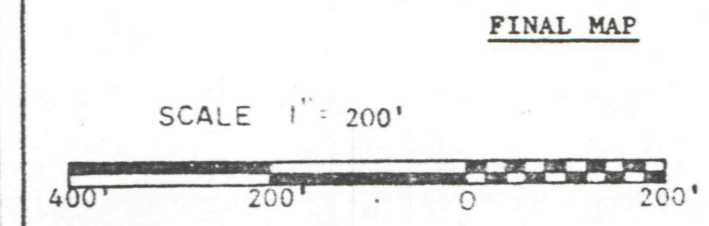

DATE PREPARED:  
 2-23-87