


SURVEY LEGEND

- A JUN 10, 1966
- B JUL 8, 1966
- C AUG 5, 1966
- D NOV 9, 1966
- E DEC 20, 1966
- F JAN 25, 1967
- G FEB 10, 1967
- H MAR 8, 1967
- I MAR 22, 1967
- J MAY 11, 1967
- K JUN 30, 1967
- L JUL 25, 1967
- M AUG 11, 1967
- N AUG 18, 1967
- O SEPT 1, 1967
- P SEPT 28, 1967
- Q OCT 13, 1967
- R OCT 24, 1967
- S NOV 8, 1967
- T DEC 6, 1967
- U DEC 25, 1967
- V JAN 7, 1968
- W FEB 5, 1968
- X FEB 28, 1968
- Y MAR 11, 1968
- Z APR 2, 1968
- AA APR 18, 1968
- AB MAY 8, 1968
- AC MAY 25, 1968
- AD JUN 13, 1968
- AE JUL 5, 1968
- AF JUL 26, 1968
- AG SEPT 11, 1968
- AH OCT 7, 1968
- AI NOV 24, 1968
- AJ DEC 17, 1968
- AK JAN 10, 1969

Proposed Six Months
OPERATION
JANUARY 19, 1969, to JULY 10, 1969

W. T. MCGREGOR, EST

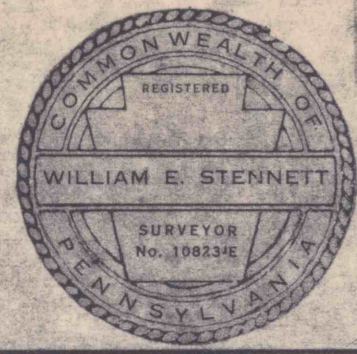

COAL MINE MAP		
GOLDEN MINE		
PROJECT		
FOR MARKLE BULLERS COAL CO.		
LOCATION PORTER TOWNSHIP, JEFFERSON COUNTY, PA.		
R. B. SHANNON & ASSOCIATES INC., KITTANNING, PA.		
DRAWN BY W.E.S.	CHECKED BY D.S.S.	DATE SEPT 1966
SCALE 1 INCH = 200 FEET	DRAWING NO. G 84	

#593
6-27-69
E.C.